



8845 Red Oak Blvd Charlotte, NC 28217 704.586.2520 p 704.523.2235 f www.singlesourcedesignbuild.com

November 2, 2012

Village At Plantation Estates / Rezoning Development Standards

To: Town of Matthews Board of Commissioners

Project: Village at Plantation Estates (V@PE)
Matthews, North Carolina
Rezoning Petition No. 589
SSDB Project 001-01-002

Content: Development Standards Revised - Village at Plantation Estates Rezoning Public Hearing

Combined Maximum Unit Count & Minimum Parking Space Table:

Matthews Zoning Code Section 153.117 Schedule Of Off-Street Parking requires 1.1 parking spaces per each Independent Living Unit and 1 space for every 4 patient beds (.25) in the Healthcare Nursing Home or Home for the Aged Building, plus 1 space for every 2 staff on the shift of greatest staff employment. "Total Parking Provided" will include +15% of "Total Required Parking" for the Visitors for each phase:

	Max. Units	Min. Parking
Total Independent Living Units (Simplex/Duplex/Triplex/Apartment):	300	330
Total Healthcare Building Beds (Assisted Living/Skilled Nursing):	<u>140</u>	35
Total Combined Independent + Healthcare Units / Staff (50) Parking:	440	<u>25</u>
Total Parking Required: Independent Living + Healthcare + Staff:		390
Total Proposed Village at Plantation Estates Visitor Parking (15%):		<u>60</u>
Total Parking Provided: Independent + Healthcare + Staff + Visitors:		450

Development Standards:

1. The development of the site will be controlled by the standards depicted on this site plan and by the Matthews Zoning Code to accommodate a Continuing Care Retirement Community in this R-1 (CD). The development will have independent living units, healthcare beds and their related accessory uses. No other uses that might be allowed in the R-1 district are proposed to be located on the project site. The density on the site will not exceed 10 dwelling units per acre. The site will include a variety of dwelling styles and sizes and may include small service uses as allowed by the provisions of Section 153.195 (A) (6) for the sole use and convenience of the residents, their guests, vendors and the staff.
2. The development depicted on this site plan is intended to reflect the arrangement of proposed uses on the site, but the exact configuration, placement, and size of individual site elements may be altered or modified within the limits prescribed herein and by the Matthews Zoning Code during the design development and construction phases. Minor adjustments and amendments to the site plan may be considered so long as the Matthews Zoning Code, the overall concept for the site, and the conditions of the site plan are preserved. Additional changes and modifications of the site plan may be proposed that are in conformance with the provisions of Section 153.201(E) of the Matthews Zoning Code.
3. At no time will the total number of independent living units on the site exceed 300. The petitioner reserves the right to modify the number of each individual unit type based on market conditions. Additionally, at no time will the total number of assisted living beds and/or skilled nursing beds exceed 140. The site may also include a resident clubhouse with offices, wellness center, and bistro.



8845 Red Oak Blvd Charlotte, NC 28217 704.586.2520 p 704.523.2235 f www.singlesourcedesignbuild.com

It may also contain a maintenance building, gatehouse and other site amenities. For each building type listed below, the established limits will not be exceeded. **The Petitioner will limit the height of any buildings located within 100'-0" of the Freemont Street property line between South Trade Street and Fullwood Lane to two-stories (35'-0") above grade.**

4. The maximum square footage of each single family home (simplex) will not exceed 3,000 square feet, exclusive of the garage; two-family home (duplex) will not exceed 6,000 square feet, exclusive of the garage; and three-family home (triplex) will not exceed 9,000 square feet, exclusive of the garage. The maximum combined square footage of these homes will not exceed 300,000 square feet. These homes will have up to four bedrooms and **each individual unit** will have a one or two car garage. The maximum number of each home type is 70 simplex buildings or 70 living units, 50 duplex buildings or 100 living units, and 30 triplex buildings or 90 living units. These homes will be up to one and a half stories high and will not exceed 35 feet, as measured per the Matthews Zoning Code.
5. The maximum square footage of each apartment building will not exceed 60,000 square feet, exclusive of the garage. The maximum combined square footage of these apartment buildings will not exceed 825,000 square feet. These apartments will have up to three bedrooms on up to three levels of residential floors and may include under-building/ground garages. These apartment buildings will be up to four stories in height and include up to 24 living units per building. These apartment buildings will not exceed 270 total living units. The maximum height of the apartment buildings will not exceed 60 feet, as measured per the Matthews Zoning Code.
6. The maximum square footage of the resident clubhouse building will not exceed 30,000 square feet. This building may include administration offices, meeting facilities, kitchen and dining facilities, swimming pools, exercise spaces, maintenance shops, apartments and other ancillary services. This building will be up to four stories in height and may include under-building/ground garages. The maximum height of this building will not exceed 60 feet, as measured per the Matthews Zoning Code.
7. The maximum square footage of the skilled nursing/assisted living buildings will not exceed 150,000 square feet exclusive of the garage, and will not exceed 140 beds. These buildings will be up to four stories in height. The maximum height of the skilled nursing/assisted living buildings will not exceed 60 feet, as measured per the Matthews Zoning Code.
8. The Petitioner has provided building elevations for the structures to be constructed on the site. The building illustrations that are included with this petition are intended to reflect the general mass, scale, configuration, and the architectural character of the buildings. The Petitioner may make revisions to the design and materials of the buildings so long as the general mass, scale, configuration, and architectural character of the buildings are maintained in accordance with the Matthews Zoning Code.
9. Brick or stone will be used on a minimum of 50% of **the combined total area of building elevations throughout the development to achieve architectural building variety, upon final phase build-out, regardless of whether a building fronts upon either an exterior public street or internal private street.** Each elevation may incorporate additional masonry materials such as decorative block, **cement-plank siding and exterior insulation finish system** or stucco. **These requirements shall apply to the simplex, duplex, triplex, maison-court and clubhouse buildings and their garages.** Other materials used on the site may include, but are not limited to, fiberglass shingles on sloped roofs, metal on mansard and pitched roofs, and single ply membranes on flat roofs. **Additional architectural variety will be achieved on the site through multiple façade designs for adjacent buildings with the same floor plan.**



8845 Red Oak Blvd Charlotte, NC 28217 704.586.2520 p 704.523.2235 f www.singlesourcedesignbuild.com

10. This development will be constructed in phases subject to modifications based on market conditions and other site conditions. Transportation improvements contained herein will be incorporated into the site phase development process as the various portions of the site are developed. To coordinate with construction of proposed roadway improvement projects planned by the Town of Matthews, the Petitioner reserves the right to provide payment in lieu of the construction of curb and gutter along portions of South Trade Street and Fullwood Lane.
11. The Petitioner shall work with Matthews United Methodist Church and the Town of Matthews to relocate Country Place Drive through the Church's property to align with the main entrance into the site. The Petitioner will bear all reasonable cost of the construction of these improvements as well as the reasonable cost of a traffic signal either when warranted or approved by the appropriate governing body having jurisdiction over the road. These improvements will be installed as a part of Phase I, except for the traffic signal installation, which may come at a later date when approval is obtained.
12. The Petitioner reserves the right to sell or develop the remainder of the property known as Tax Parcel # 22715201 located across Fullwood Lane that is not used for the road connection to Hampton Green. This property is not to be re-zoned herewith and shall remain as current zoning classification R-15.
13. Parking will be provided in accordance with the Matthews Zoning Code Section 153.117 Schedule of Off-Street Parking. Parking will be provided in garages associated with each simplex/duplex/triplex home. Parking for apartment buildings will be provided in under-building/ground garages where subsurface conditions allow, surface lots and on-street parking areas. The Petitioner reserves the right to also provide on-street pull-in and parallel parking spaces on the internal private streets in addition to the parking spaces shown on the site plan. The Parking Plan required by Section 153.123 of the Matthews Zoning Code will be submitted as a separate document from this Rezoning Petition with each site phase.
14. Signage will be permitted in accordance with the Matthews Zoning Code Section 153.150. Detached signage will be limited to ground mounted monument signs that will identify the development at each public street vehicular access road limited to 40 square feet in area for each sign. It is the intent of the petitioner to locate signage at/near the main entrance on South Trade Street and at/near the entrance at Fullwood Lane as permitted by the Schedule of Sign Regulations. The materials of these signs will be compatible with the materials used to construct the buildings on the site. The Internal directional signage may also be utilized on either a temporary or permanent basis. The Master Sign Plan required by Section 153.149 of the Matthews Zoning Code will be submitted as a separate document from this Rezoning Petition.
15. Fire Department site access will be provided by a driveway connection at South Trade Street and a driveway connection at Fullwood Lane. Temporary emergency access may be provided from Fullwood Lane due to the phasing of the site development. The Petitioner reserves the right to provide vehicle and pedestrian gates at both of these access points. All gates will be accessible by emergency services per the Town of Matthews Ordinance. There will not be an internal street connection with Freemont Street.
16. The site will be designed and constructed to comply with the Town of Matthews Fire Department Standards. Fire Hydrant locations will be provided in compliance with the NC State Fire Code. All stream crossings and emergency service roads or pathways will be built to withstand loads of 80,000 pounds and an 8 foot wheel base.



8845 Red Oak Blvd Charlotte, NC 28217 704.586.2520 p 704.523.2235 f www.singlesourcedesignbuild.com

17. The apartment buildings and garages will be equipped with fire alarm systems and automatic sprinkler systems as required by the NC State Building Code.
18. The Petitioner will install a 10 foot wide multi-use path with pedestrian lighting on the edge of the property along South Trade Street in Phase I of the site development with a pedestrian signal where the greenway crosses South Trade Street. A 10 foot wide multi-use path with pedestrian lighting will also be installed on the edge of the property along Fullwood Lane in Phase III of the site development. The exact locations of the multi-use paths will be determined during the development review and approval process. The Petitioner will provide a greenway access and use easement on its property for any portion of the multi-use paths indicated on the site plan that is outside of the public street right-of-way. The Petitioner reserves the right to provide payment in lieu of the construction of the multi-use paths due to the future construction of the proposed roadway projects along South Trade Street and Fullwood Lane. The Petitioner will install an internal sidewalk system that will connect the housing units on the site with the multi-use paths and sidewalks on the adjacent public streets.
19. The Petitioner will dedicate up to an additional 15 feet of right-of-way along Fullwood Lane and South Trade Street, measured from existing street right-of-way lines, within 400 feet of the intersection of Fullwood Lane and South Trade Street, as required to accommodate future Town of Matthews road projects in the vicinity of the site. The Petitioner reserves the right to provide payment in lieu of the construction of the curb and gutter and sidewalks due to the future construction of the proposed roadway projects along South Trade Street and Fullwood Lane. Any public pathways and sidewalks located around the perimeter of the site shall be located within a pedestrian access easement in any areas where said pathways leave the public right of way.
20. The Petitioner will install 30 foot wide streetscape landscape areas along Fullwood Lane and South Trade Streets, as generally indicated on the site plan and measured from the street right of ways. No buildings or parking will be placed within these landscape areas. Existing trees and shrubs preserved within these areas may be used to meet the landscape requirements of the Ordinance. Additionally, new trees and shrubs may be added to these landscape areas as required to meet Zoning Ordinance requirements. Landscaped berms, sidewalks, and/or greenway trails may be installed within these landscape areas. The Petitioner reserves the right to selectively clear underbrush, invasive weeds, and poison ivy within the 30 foot landscaped areas in accordance with the Ordinance.
21. The Petitioner will install 30 foot wide perimeter landscape areas along the project perimeter adjacent to existing residential development, as generally indicated on the site plan. No buildings, parking, or detention ponds will be placed within these landscape areas. Existing trees and shrubs will be preserved within these perimeter areas whenever practical. Additionally, new trees and shrubs may be added to these landscape areas to meet Town of Matthews Zoning Ordinance requirements. The Petitioner reserves the right to selectively clear underbrush, invasive weeds, and poison ivy within the 30 foot landscape areas in accordance with the Ordinance.
22. The Petitioner may install fencing and/or screen walls along the perimeter of the site, provided that fencing or screen walls shall be no closer than 15 feet to any exterior property line. Entry signage and associated decorative walls may be closer to street right of ways, subject to Ordinance requirements. Finish materials of the fences or walls may include brick, stone, EIFS or comparable, decorative metal, aluminum, manufactured wood and wood. The finished side of fencing/screen walls shall face outward from the property.



8845 Red Oak Blvd Charlotte, NC 28217 704.586.2520 p 704.523.2235 f www.singlesourcedesignbuild.com

23. Approximate tree save areas are shown on the Tree Protection Plan. The Petitioner may supplement the existing trees per Ordinance guidelines. The Petitioner also reserves the right to provide tree planting mitigation (replanting) in accordance with the Town of Matthews Ordinance guidelines.
24. The minimum unobstructed open space for the site is 50% in conformance with Section 153.195 of the Matthews Zoning Code at Table 1 for Continuing Care Retirement Communities.
25. All outdoor lighting shall comply with the Matthews Zoning Code. No open lens lighting will be installed, but architectural lighting on building facades and landscape areas will be permitted.
26. The Petitioner reserves the right to demolish the existing brick wall along South Trade Street to install road improvements, greenway trails/sidewalks, and/or landscape improvements. The existing concrete monument will be donated to the Town of Matthews for reuse at an off-site location.
27. There is an existing pond on the site. The Petitioner may, during the construction of the site, drain, clean and redesign this pond to better accommodate storm water and develop a more attractive open space and open space amenity. As a result, the final location and dimensions of the pond may be modified during construction.
28. Project wide water quality features, including storm water detention facilities, will be designed to meet the applicable standards of the Town of Matthews, including the Phase 2 controls (post-construction) standards.
29. SWIM buffers will be provided in accordance with the Mecklenburg County Ordinance requirements.
30. Throughout this Rezoning Petition, the terms "Owner", "Owners", "Petitioner" or "Petitioners", shall, with respect to the Site, be deemed to include the heirs, devisees, agents, personal representatives, successors in interested and assignees of the owner or owners of the Site who may be involved in its development from time to time.
31. The Petitioner will install a 5 foot wide sidewalk along South Trade Street in front of the two existing adjacent house lots from the ACTS property line on the North side toward Main Street.
32. The Petitioner will install a traffic signal at the Fullwood Lane driveway entrance as part of Phase III or at the time that the Fullwood Lane driveway is constructed.
33. The Petitioner will pay property taxes in a manner similar to the taxes paid by Plantation Estates to the Town of Matthews and the County of Mecklenburg even though the Village at Plantation Estates is a not-for-profit 501(c)(3) entity and even if the Continuing Care Retirement Community might otherwise be fully or partially exempted from the payment of any such taxes. As such, the Petitioner reserves all rights and privileges accorded to any other property tax payer. This may be accomplished through use of a Payment in Lieu of Taxes program or such other method as mutually agreed upon.
34. To enhance traffic flow in the area, the Petitioner commits to working with the Town of Matthews and the Residents of Hampton Green to provide the Hampton Green Neighborhood with a road connection to Fullwood Lane from Whitefriars Lane. The Petitioner will bear the reasonable cost of the property acquisition and the construction of this off-site Community benefit. This benefit will be installed prior to the issuance of the first Certificate of Occupancy for the Village at Plantation Estates and shall be coordinated with the South Trade Street and Fullwood Lane Intersection Road Project.



8845 Red Oak Blvd Charlotte, NC 28217 704.586.2520 p 704.523.2235 f www.singlesourcedesignbuild.com

- 35. The Petitioner will bury the existing overhead utilities (or abandon where appropriate) that are located along the South Trade Street frontage of the Site Plan parcel.
- 36. The Petitioner will provide and maintain a primary construction traffic site access on Fullwood Lane in order to minimize construction traffic on South Trade Street, however some construction traffic must access the site from South Trade Street in order to build and complete that portion of the project.

These Proposed V@PE Rezoning Development Standards are believed to correspond with the Site Plan. If there are any incongruences or inconsistencies, please contact me at 704-586-2433. Thank you.

Respectfully Submitted,
Single source Design-Build

A handwritten signature in red ink that reads 'Bob Romano'.

Bob Romano, AIA, A-DBIA, CCCA, LEED AP
Design-Build Project Manager


Cc: Kathi Ingrish, AICP – Planning Director
Jay Camp – Senior Planner
Marvin Mashner, CPA - ACTS P & CEO
Jeff Rathfon, SVP – ACTS Development
Steve Egges, RVP – Mid-South Director
Tom Strader, RD – ACTS Development
Brunson Russum, AIA – SSDB President
Matt Langston, ASLA – LWDG Manager
Tom McCrory, ASLA – LWDG Designer
Steve Wilson, PE – LWDG Civil Engineer
Steve Chomick, AIA – FreemanWhite, Inc.
Marc Gibson, PE, SE – WGPM Principal

Development Standards:

- The development of the site will be controlled by the standards depicted on this site plan and by the Matthews Zoning Code to accommodate a Continuing Care Retirement Community in this R-1 (CD). The development will have independent living units, healthcare beds and their related accessory uses. No other uses that might be allowed in the R-1 district are proposed to be located on the project site. The density on the site will not exceed 10 dwelling units per acre. The site will include a variety of dwelling styles and sizes and may include small service uses as allowed by the provisions of Section 153.195 (A) (6) for the sole use and convenience of the residents, their guests, vendors and the staff.
- The development depicted on this site plan is intended to reflect the arrangement of proposed uses on the site, but the exact configuration, placement, and size of individual site elements may be altered or modified within the limits prescribed herein and by the Matthews Zoning Code during the design development and construction phases. Minor adjustments and amendments to the site plan may be considered so long as the Matthews Zoning Code, the overall concept for the site, and the conditions of the site plan are preserved. Additional changes and modifications of the site plan may be proposed that are in conformance with the provisions of Section 153.201(E) of the Matthews Zoning Code.
- At no time will the total number of independent living units on the site exceed 300. The petitioner reserves the right to modify the number of each individual unit type based on market conditions. Additionally, at no time will the total number of assisted living beds and/or skilled nursing beds exceed 140. The site may also include a resident clubhouse with offices, wellness center, and bistro. It may also contain a maintenance building, gatehouse and other site amenities. For each building type listed below, the established limits will not be exceeded. The Petitioner will limit the height of any buildings located within 100'-0" of the Freemont Street property line between South Trade Street and Fullwood Lane to two-stories (35'-0") above grade.
- The maximum square footage of each single family home (simplex) will not exceed 3,000 square feet, exclusive of the garage; two-family home (duplex) will not exceed 6,000 square feet, exclusive of the garage; and three-family home (triplex) will not exceed 9,000 square feet, exclusive of the garage. The maximum combined square footage of these homes will not exceed 300,000 square feet. These homes will have up to four bedrooms and each individual unit will have a one or two car garage. The maximum number of each home type is 70 simplex buildings or 70 living units, 50 duplex buildings or 100 living units, and 30 triplex buildings or 90 living units. These homes will be up to one and a half stories high and will not exceed 35 feet, as measured per the Matthews Zoning Code.
- The maximum square footage of each apartment building will not exceed 60,000 square feet, exclusive of the garage. The maximum combined square footage of these apartment buildings will not exceed 825,000 square feet. These apartments will have up to three bedrooms on up to three levels of residential floors and may include under-building/ground garages. These apartment buildings will be up to four stories in height and include up to 24 living units per building. These apartment buildings will not exceed 270 total living units. The maximum height of the apartment buildings will not exceed 60 feet, as measured per the Matthews Zoning Code.
- The maximum square footage of the resident clubhouse building will not exceed 30,000 square feet. This building may include administration offices, meeting facilities, kitchen and dining facilities, swimming pools, exercise spaces, maintenance shops, apartments and other ancillary services. This building will be up to four stories in height and may include under-building/ground garages. The maximum height of this building will not exceed 60 feet, as measured per the Matthews Zoning Code.
- The maximum square footage of the skilled nursing/assisted living buildings will not exceed 150,000 square feet exclusive of the garage, and will not exceed 140 beds. These buildings will be up to four stories in height. The maximum height of the skilled nursing/assisted living buildings will not exceed 60 feet, as measured per the Matthews Zoning Code.
- The Petitioner has provided building elevations for the structures to be constructed on the site. The building illustrations that are included with this petition are intended to reflect the general mass, scale, configuration, and the architectural character of the buildings. The Petitioner may make revisions to the design and materials of the buildings so long as the general mass, scale, configuration, and architectural character of the buildings are maintained in accordance with the Matthews Zoning Code.
- Brick or stone will be used on a minimum of 50% of the combined total area of building elevations throughout the development to achieve architectural building variety, upon final phase build-out, regardless of whether a building fronts upon either an exterior public street or internal private street. Each elevation may incorporate additional masonry materials such as decorative block, cement-plank siding and exterior insulation finish system or stucco. These requirements shall apply to the simplex, duplex, triplex, maison-court and clubhouse buildings and their garages. Other materials used on the site may include, but are not limited to, fiberglass shingles on sloped roofs, metal on mansard and pitched roofs, and single ply membranes on flat roofs. Additional architectural variety will be achieved on the site through multiple façade designs for adjacent buildings with the same floor plan.
- This development will be constructed in phases subject to modifications based on market conditions and other site conditions. Transportation improvements contained herein will be incorporated into the site phase development process as the various portions of the site are developed. To coordinate with construction of proposed roadway improvement projects planned by the Town of Matthews, the Petitioner reserves the right to provide payment in lieu of the construction of curb and gutter along portions of South Trade Street and Fullwood Lane.
- The Petitioner shall work with Matthews United Methodist Church and the Town of Matthews to relocate Country Place Drive through the Church's property to align with the main entrance into the site. The Petitioner will bear all reasonable cost of the signal either the construction of these improvements as well as the reasonable cost of a traffic signal either when warranted or approved by the appropriate governing body having jurisdiction over the road. These improvements will be installed as a part of Phase I, except for the traffic signal installation, which may come at a later date when approval is obtained.
- The Petitioner reserves the right to sell or develop the remainder of the property known as Tax Parcel # 22715201 located across Fullwood Lane that is not used for the road connection to Hampton Green. This property is not to be re-zoned herewith and shall remain as current zoning classification R-15.

- Parking will be provided in accordance with the Matthews Zoning Code Section 153.117 Schedule of Off-Street Parking. Parking will be provided in garages associated with each simplex/duplex/triplex home. Parking for apartment buildings will be provided in under-building/ground garages where subsurface conditions allow, surface lots and on-street parking areas. The Petitioner reserves the right to also provide on-street pull-in and parallel parking spaces on the internal private streets in addition to the parking spaces shown on the site plan. The Parking Plan required by Section 153.123 of the Matthews Zoning Code will be submitted as a separate document from this Rezoning Petition with each site phase.
- Signage will be permitted in accordance with the Matthews Zoning Code Section 153.150. Detached signage will be limited to ground mounted monument signs that will identify the development at each public street vehicular access road limited to 40 square feet in area for each sign. It is the intent of the petitioner to locate signage at/near the main entrance on South Trade Street and at/near the entrance at Fullwood Lane as permitted by the Schedule of Sign Regulations. The materials of these signs will be compatible with the materials used to construct the buildings on the site. The Internal directional signage may also be utilized on either a temporary or permanent basis. The Master Sign Plan required by Section 153.149 of the Matthews Zoning Code will be submitted as a separate document from this Rezoning Petition.
- Fire Department site access will be provided by a driveway connection at South Trade Street and a driveway connection at Fullwood Lane. Temporary emergency access may be provided from Fullwood Lane due to the phasing of the site development. The Petitioner reserves the right to provide vehicle and pedestrian gates at both of these access points. All gates will be accessible by emergency services per the Town of Matthews Ordinance. There will not be an internal street connection with Freemont Street.
- The site will be designed and constructed to comply with the Town of Matthews Fire Department Standards. Fire Hydrant locations will be provided in compliance with the NC State Fire Code. All stream crossings and emergency service roads or pathways will be built to withstand loads of 80,000 pounds and an 8 foot wheel base.
- The apartment buildings and garages will be equipped with fire alarm systems and automatic sprinkler systems as required by the NC State Building Code.
- The Petitioner will install a 10 foot wide multi-use path with pedestrian lighting on the edge of the property along South Trade Street in Phase I of the site development with a pedestrian signal where the greenway crosses South Trade Street. A 10 foot wide multi-use path with pedestrian lighting will also be installed on the edge of the property along Fullwood Lane in Phase III of the site development. The exact locations of the multi-use paths will be determined during the development review and approval process. The Petitioner will provide a greenway access and use easement on its property for any portion of the multi-use paths indicated on the site plan that is outside of the public street right-of-way. The Petitioner reserves the right to provide payment in lieu of the construction of the multi-use paths due to the future construction of the proposed roadway projects along South Trade Street and Fullwood Lane. The Petitioner will install an internal sidewalk system that will connect the housing units on the site with the multi-use paths and sidewalks on the adjacent public streets.
- The Petitioner will dedicate up to an additional 15 feet of right-of-way along Fullwood Lane and South Trade Street, measured from existing street right-of-way lines, within 400 feet of the intersection of Fullwood Lane and South Trade Street, as required to accommodate future Town of Matthews road projects in the vicinity of the site. The Petitioner reserves the right to provide payment in lieu of the construction of the curb and gutter and sidewalks due to the future construction of the proposed roadway projects along South Trade Street and Fullwood Lane. Any public pathways and sidewalks located around the perimeter of the site shall be located within a pedestrian access easement in any areas where said pathways leave the public right of way.
- The Petitioner will install 30 foot wide streetscape landscape areas along Fullwood Lane and South Trade Streets, as generally indicated on the site plan and measured from the street right of ways. No buildings or parking will be placed within these landscape areas. Existing trees and shrubs preserved within these areas may be used to meet the landscape requirements of the Ordinance. Additionally, new trees and shrubs may be added to these landscape areas as required to meet Zoning Ordinance requirements. Landscaped berms, sidewalks, and/or greenway trails may be installed within these landscape areas. The Petitioner reserves the right to selectively clear underbrush, invasive weeds, and poison ivy within the 30 foot landscaped areas in accordance with the Ordinance.
- The Petitioner will install 30 foot wide perimeter landscape areas along the project perimeter adjacent to existing residential development, as generally indicated on the site plan. No buildings, parking, or detention ponds will be placed within these landscape areas. Existing trees and shrubs will be preserved within these perimeter areas whenever practical. Additionally, new trees and shrubs may be added to these landscape areas to meet Town of Matthews Zoning Ordinance requirements. The Petitioner reserves the right to selectively clear underbrush, invasive weeds, and poison ivy within the 30 foot landscape areas in accordance with the Ordinance.
- The Petitioner may install fencing and/or screen walls along the perimeter of the site, provided that fencing or screen walls shall be no closer than 15 feet to any exterior property line. Entry signage and associated decorative walls may be closer to street right of ways, subject to Ordinance requirements. Finish materials of the fences or walls may include brick, stone, EIFS or comparable, decorative metal, aluminum, manufactured wood and wood. The finished side of fencing/screen walls shall face outward from the property.
- Approximate tree save areas are shown on the Tree Protection Plan. The Petitioner may supplement the existing trees per Ordinance guidelines. The Petitioner also reserves the right to provide tree planting mitigation (replanting) in accordance with the Town of Matthews Ordinance guidelines.
- The minimum unobstructed open space for the site is 50% in conformance with Section 153.195 of the Matthews Zoning Code at Table 1 for Continuing Care Retirement Communities.
- All outdoor lighting shall comply with the Matthews Zoning Code. No open lens lighting will be installed, but architectural lighting on building facades and landscape areas will be permitted.
- The Petitioner reserves the right to demolish the existing brick wall along South Trade Street to install road improvements, greenway trails/sidewalks, and/or landscape improvements. The existing concrete monument will be donated to the Town of Matthews for reuse at an off-site location.

- There is an existing pond on the site. The Petitioner may, during the construction of the site, drain, clean and redesign this pond to better accommodate storm water and develop a more attractive open space and open space amenity. As a result, the final location and dimensions of the pond may be modified during construction.
- Project wide water quality features, including storm water detention facilities, will be designed to meet the applicable standards of the Town of Matthews, including the Phase 2 controls (post-construction) standards.
- SWIM buffers will be provided in accordance with the Mecklenburg County Ordinance requirements.
- Throughout this Rezoning Petition, the terms "Owner", "Owners", "Petitioner" or "Petitioners", shall, with respect to the Site, be deemed to include the heirs, devisees, agents, personal representatives, successors in interested and assignees of the owner or owners of the Site who may be involved in its development from time to time.
- The Petitioner will install a 5 foot wide sidewalk along South Trade Street in front of the two existing adjacent house lots from the ACTS property line on the North side toward Main Street.
- The Petitioner will install a traffic signal at the Fullwood Lane driveway entrance as part of Phase III or at the time that the Fullwood Lane driveway is constructed.
- The Petitioner will pay property taxes in a manner similar to the taxes paid by Plantation Estates to the Town of Matthews and the County of Mecklenburg even though the Village at Plantation Estates is a not-for-profit 501(c)(3) entity and even if the Continuing Care Retirement Community might otherwise be fully or partially exempted from the payment of any such taxes. As such, the Petitioner reserves all rights and privileges accorded to any other property tax payer. This may be accomplished through use of a Payment in Lieu of Taxes program or such other method as mutually agreed upon.
- To enhance traffic flow in the area, the Petitioner commits to working with the Town of Matthews and the Residents of Hampton Green to provide the Hampton Green Neighborhood with a road connection to Fullwood Lane from Whitefriars Lane. The Petitioner will bear the reasonable cost of the property acquisition and the construction of this off-site Community benefit. This benefit will be installed prior to the issuance of the first Certificate of Occupancy for the Village at Plantation Estates and shall be coordinated with the South Trade Street and Fullwood Lane Intersection Road Project.
- The Petitioner will bury the existing overhead utilities (or abandon where appropriate) that are located along the South Trade Street frontage of the Site Plan parcel.
- The Petitioner will provide and maintain a primary construction traffic site access on Fullwood Lane in order to minimize construction traffic on South Trade Street, however some construction traffic must access the site from South Trade Street in order to build and complete that portion of the project.

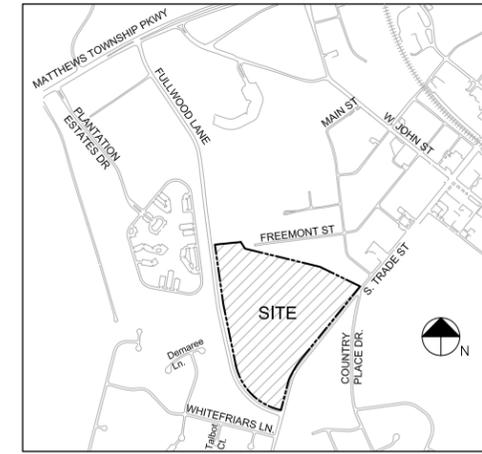

VICINITY MAP
NOT TO SCALE

COMBINED MAXIMUM UNIT COUNT & MINIMUM PARKING SPACE TABLE:

Matthews Zoning Code Section 153.117 Schedule of Off-Street Parking requires 1.1 parking spaces per each Independent Living Unit and 1 space for every 4 patient beds (.25) in the Healthcare Nursing Home or Home for the Aged, plus 1 space for every 2 staff on the shift of greatest staff employment. "Total Parking Provided" will include +15% of "Total Required Parking" for the Visitors in each phase:

	Max. Units /	Min. Parking
Total Independent Living Units (Simplex/Duplex/Triplex/Apartment):	300	330
Total Healthcare Building Beds (Assisted Living/Skilled Nursing):	140	35
Total Combined Independent + Healthcare Units / Staff (50) Parking:	440	25
Total Parking Required: Independent Living + Healthcare + Staff:		390
Total Proposed Village at Plantation Estates Visitor Parking (15%):		60
Total Parking Provided: Independent + Healthcare + Staff + Visitors:		450

SITE DATA

TAX PARCELS:	22715125, 22715124, 22715122, 22715113 22715112, 22715121, 22715114, 22715123
SITE AREA:	APPROXIMATELY 44.88 ACRES (GROSS)
EXISTING ZONING:	R4 (CD)
PROPOSED ZONING:	R4 (CD)

SHEET SCHEDULE

ZP-00	COVER SHEET
ZP-01	EXISTING CONDITIONS PLAN
ZP-02	GRAPHIC SITE PLAN
ZP-03	SITE LAYOUT PLAN
ZP-03A	ALTERNATE SITE LAYOUT PLAN
ZP-04	PHASING PLAN
ZP-05	TREE SAVE PLAN
ZP-06	GREENWAY TRAIL DETAILS
ZP-07	DETAILS
ZP-08	BUILDING ELEVATIONS
ZP-09	BUILDING ELEVATIONS
ZP-10	FULLWOOD LANE & S. TRADE STREET ROAD IMPROVEMENTS
ZP-11	DECORATIVE WALL & SIGN DETAILS

REVISIONS:

No.	Date	By	
1	8/3/12	SMW	REVISIONS PER TOWN COMMENTS
2	11/02/12	AMC	REVISIONS PER TOWN & OWNER COMMENTS



Landworks
Design Group, P.A.
7621 Little Ave., Suite 111
Charlotte, NC 28226
704-841-1604 fax: 704-841-1604



FreemanWhite



THE VILLAGE AT
PLANTATION ESTATES
MATTHEWS, NC
REZONING APPLICATION #589

COVER SHEET

Project Manager: MDL

Drawn By: MDL, TMM

Checked By:

Date: 5/31/12

Project Number: 11015

Sheet Number:

ZP-00

CURRENT

2012-589
11/2/2012



Landworks
Design Group, P.A.
7621 Little Ave., Suite 111
Charlotte, NC 28226
704-841-1604 fax: 704-841-1604



FreemanWhite



THE VILLAGE AT
PLANTATION ESTATES
MATTHEWS, NC
REZONING APPLICATION #589

GRAPHIC
SITE PLAN

Project Manager: MDL

Drawn By: MDL, TMM

Checked By:

Date: 05/31/12

Project Number: 11015

Sheet Number:


ZP-02




REVISIONS:

No.	Date	By	REVISIONS PER TOWN & OWNER COMMENTS
1	11/02/12	AMC	

P:\2011 Jobs\11015 - Village at Plantation Estates\CAD\11015 Base.dwg

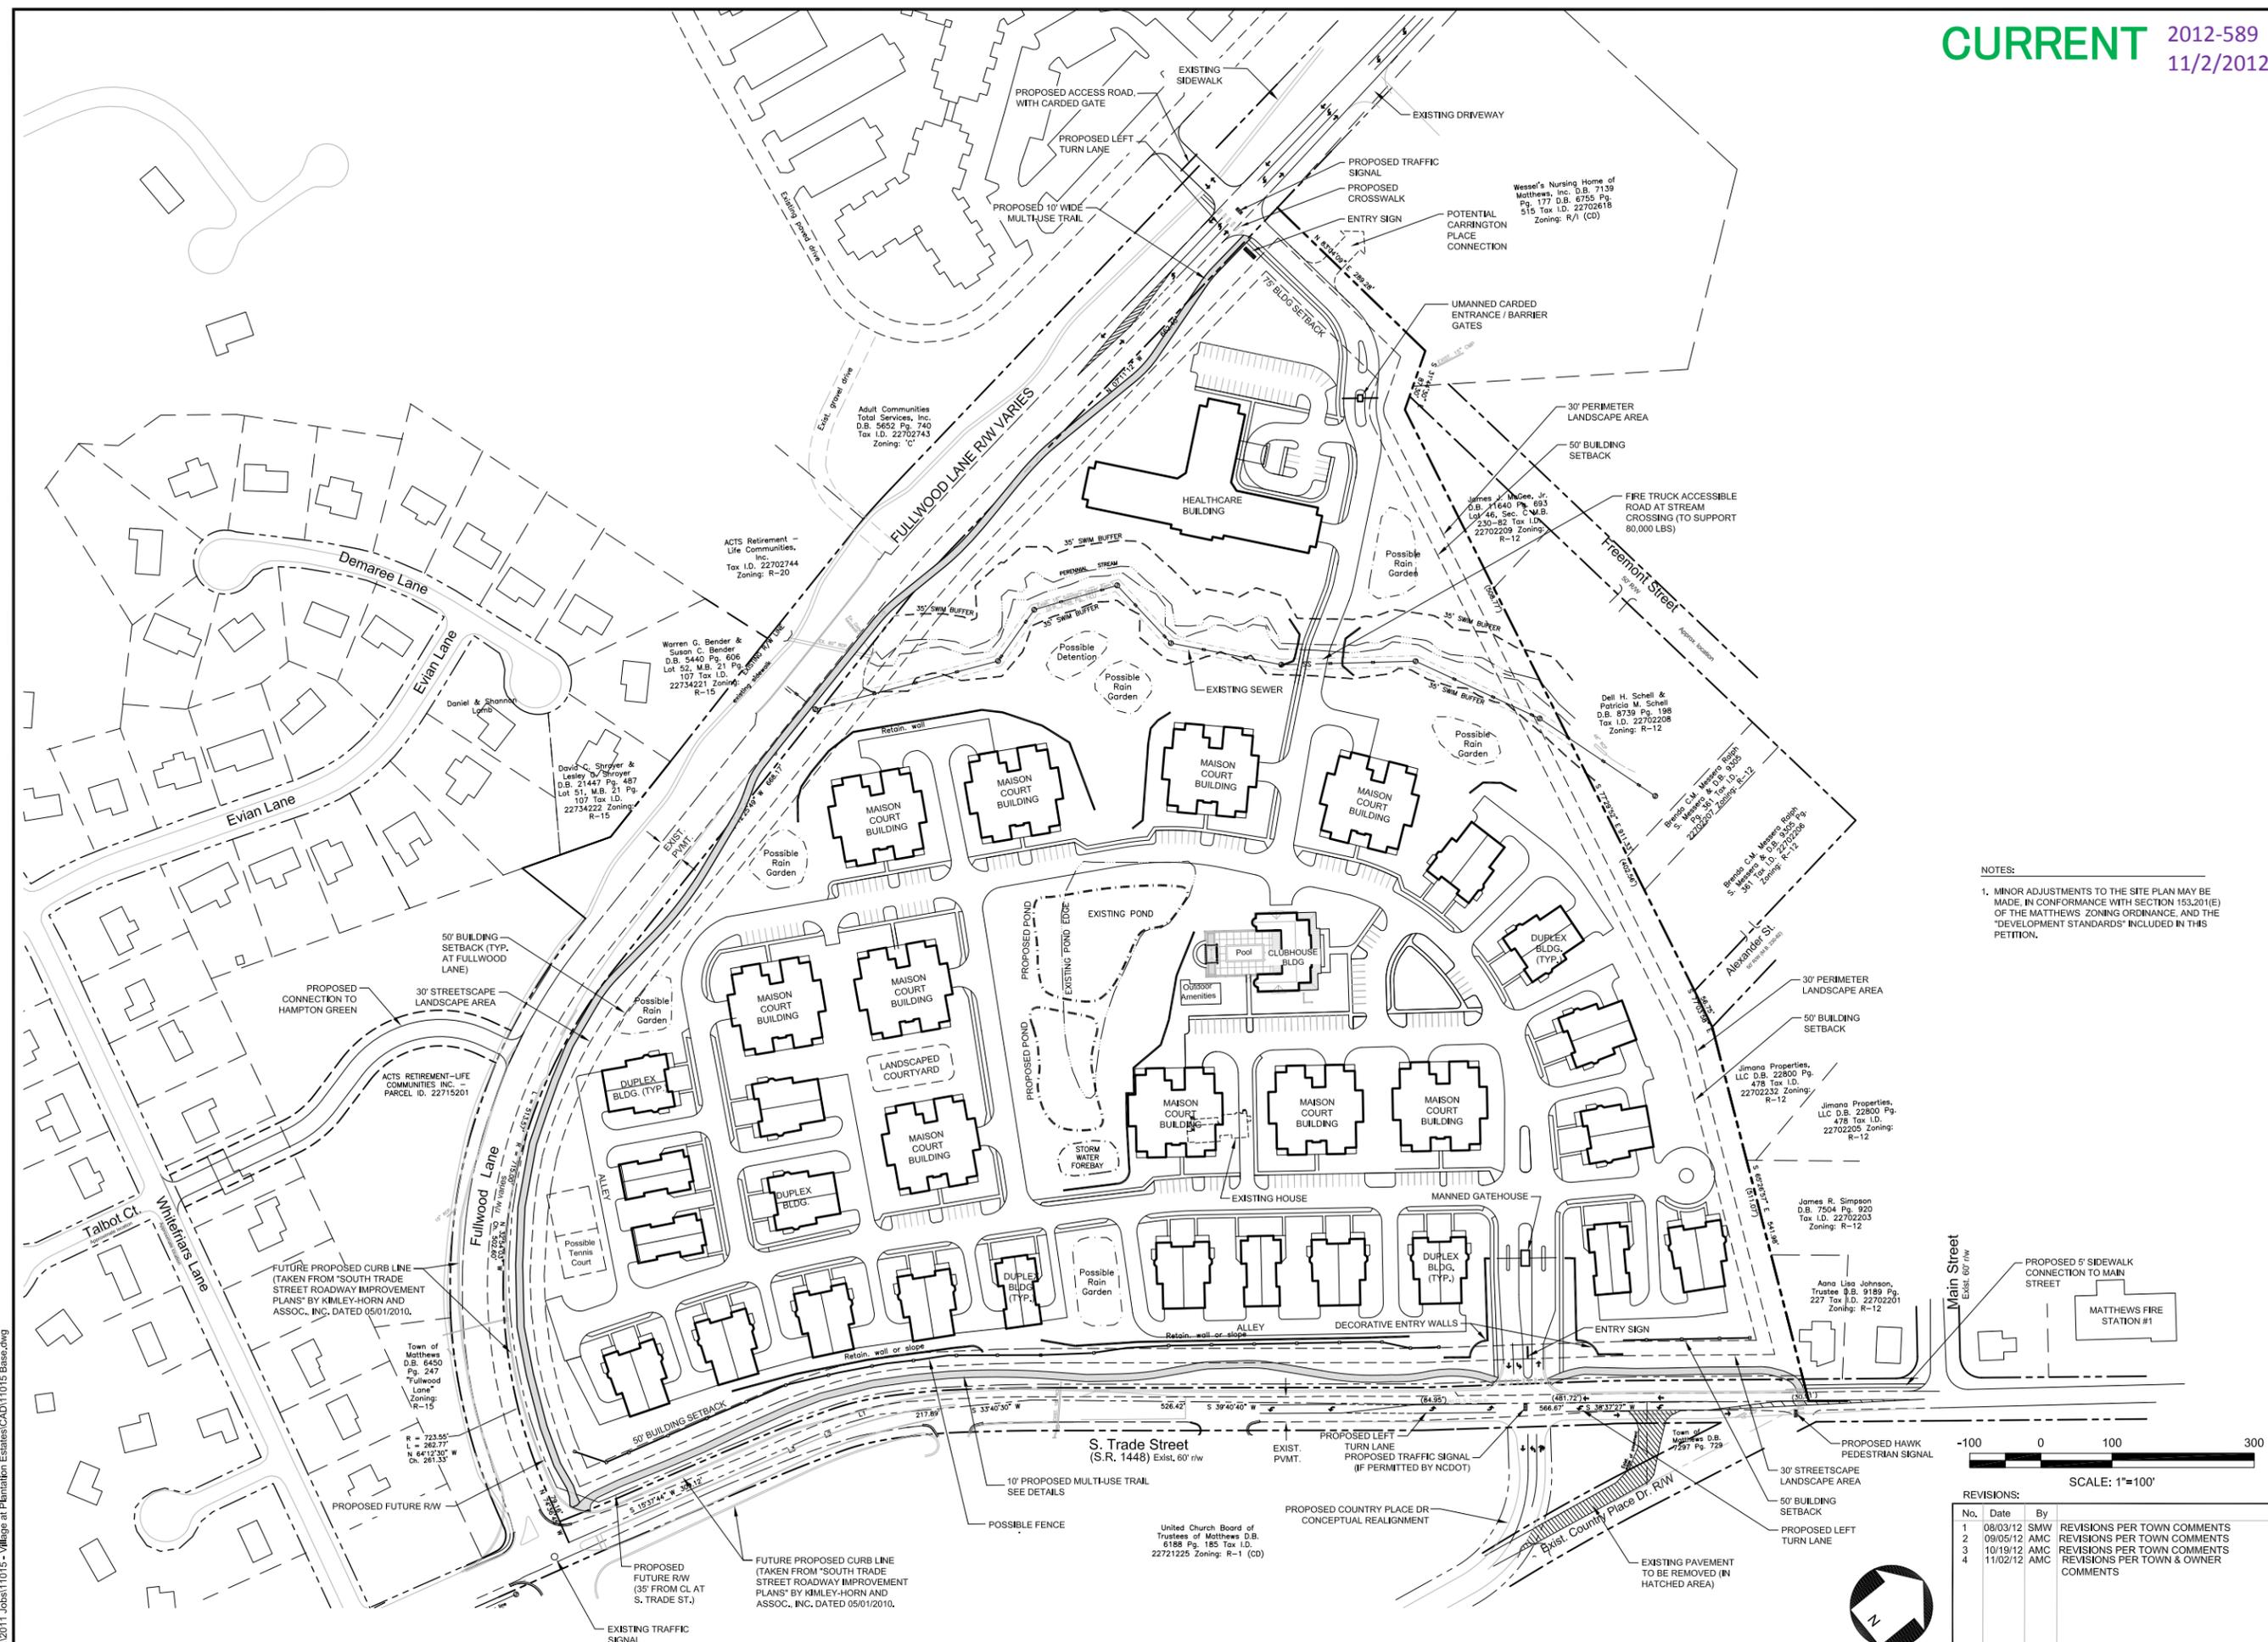

NOTES:
1. MINOR ADJUSTMENTS TO THE SITE PLAN MAY BE MADE IN CONFORMANCE WITH SECTION 153.20(1E) OF THE MATTHEWS ZONING ORDINANCE, AND THE "DEVELOPMENT STANDARDS" INCLUDED IN THIS PETITION.

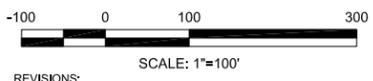

No.	Date	By	Comments
1	08/03/12	SMW	REVISIONS PER TOWN COMMENTS
2	09/05/12	AMC	REVISIONS PER TOWN COMMENTS
3	10/19/12	AMC	REVISIONS PER TOWN COMMENTS
4	11/02/12	AMC	REVISIONS PER TOWN & OWNER COMMENTS

P:\2011 Jobs\11015 - Village at Plantation Estates\CAD\11015 Base.dwg

Project Manager: MDL

Drawn By: MDL, TMM

Checked By:



Date: 08/3/12

Project Number: 11015


Sheet Number:

ZP-03A


P:\2011 Jobs\11015 - Village at Plantation Estates\CAD\11015 Alternate Layout.dwg

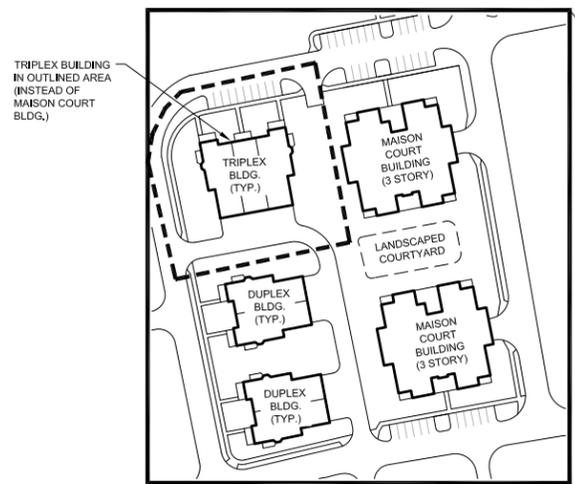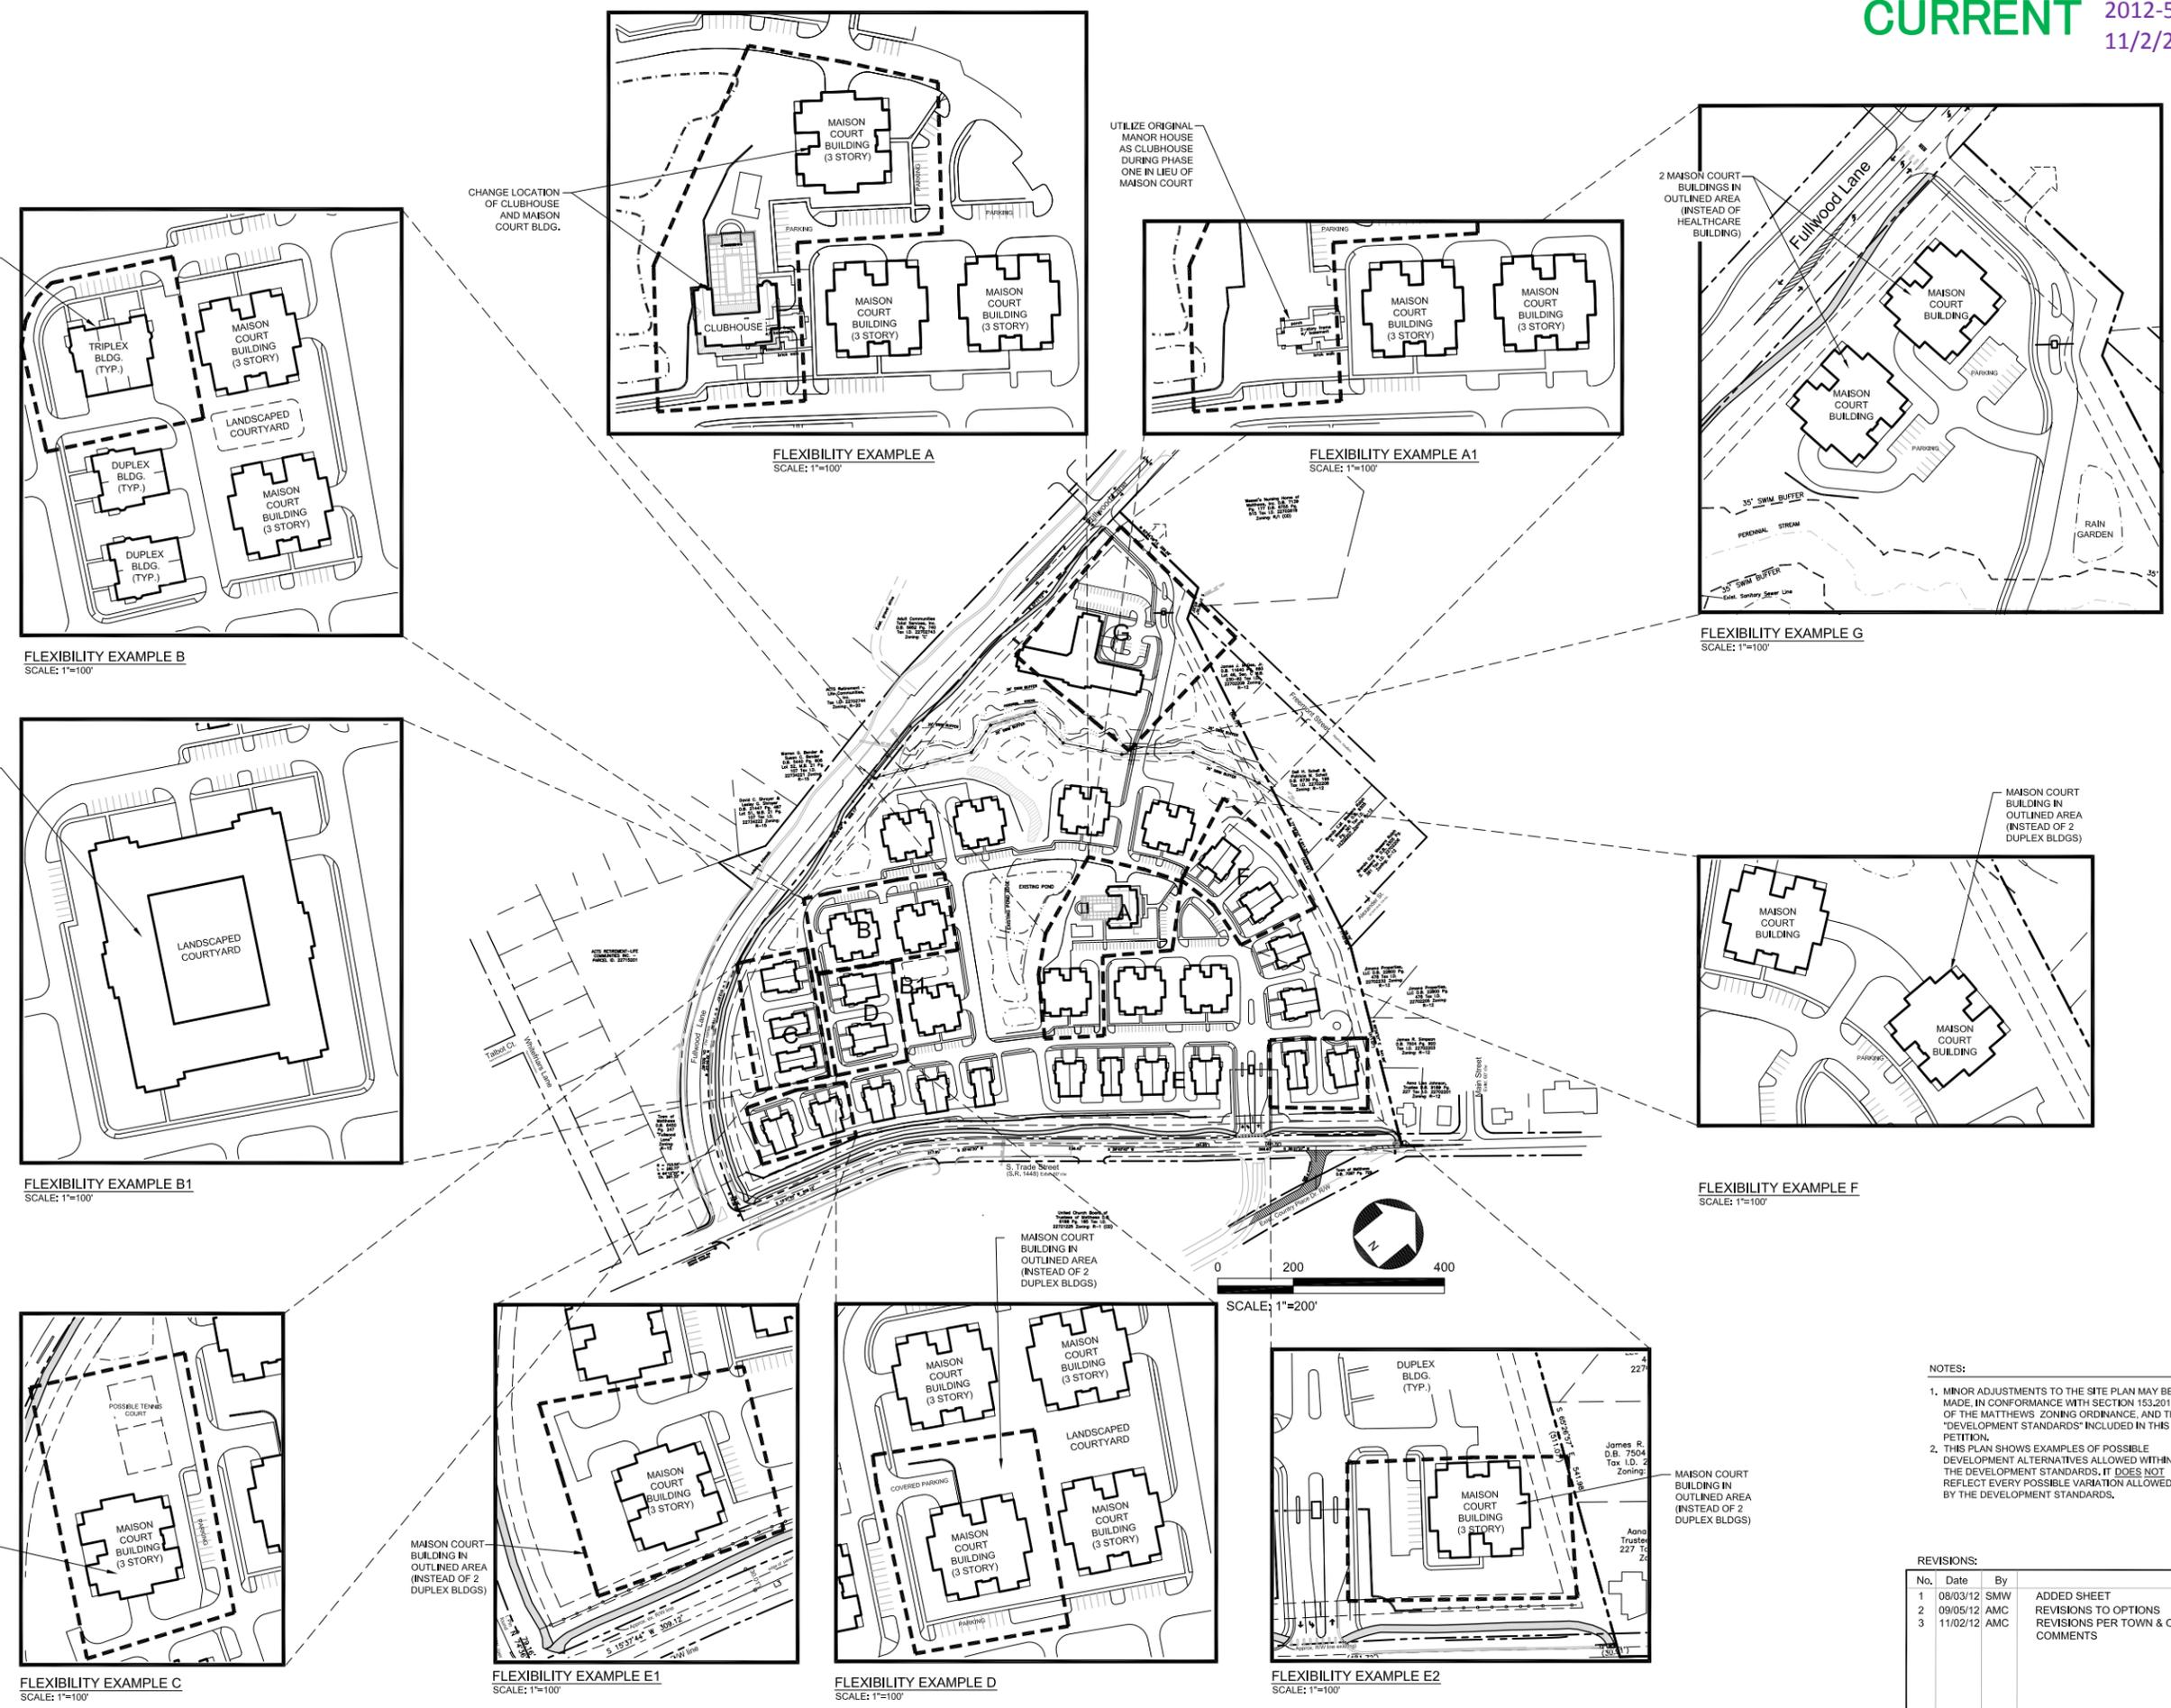


FLEXIBILITY EXAMPLE B
SCALE: 1"=100'

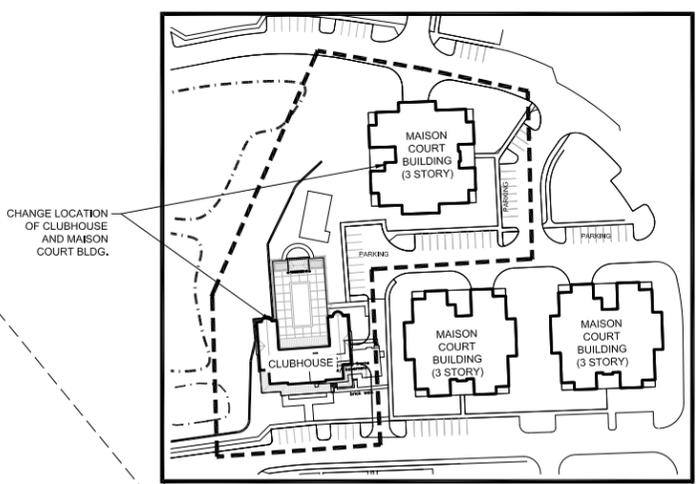


FLEXIBILITY EXAMPLE A
SCALE: 1"=100'

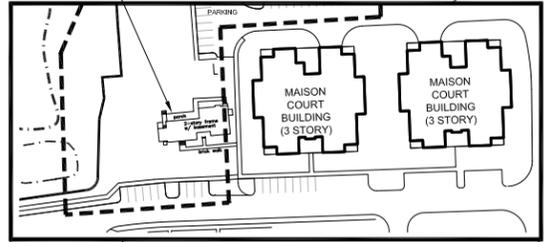

FLEXIBILITY EXAMPLE A1
SCALE: 1"=100'

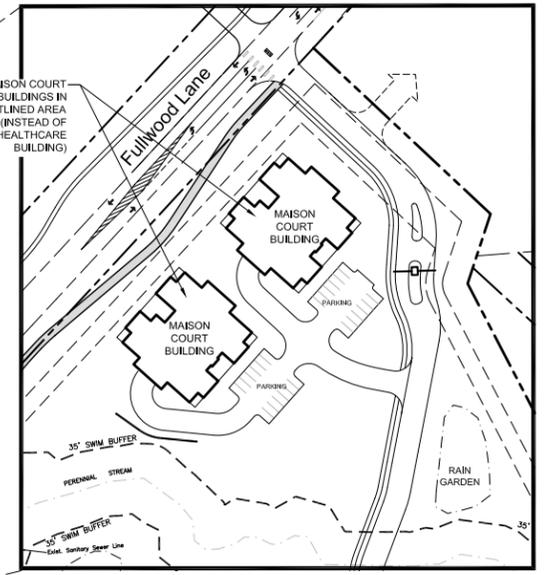


FLEXIBILITY EXAMPLE G
SCALE: 1"=100'

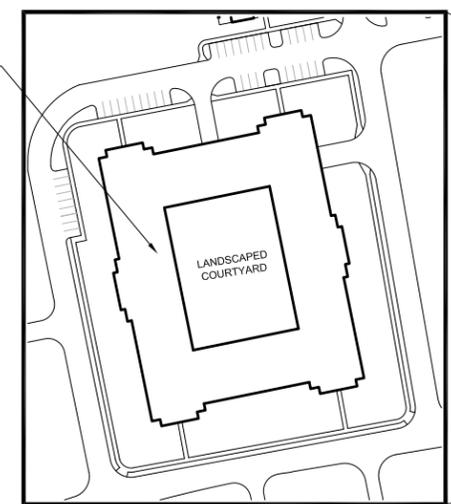


FLEXIBILITY EXAMPLE B1
SCALE: 1"=100'




FLEXIBILITY EXAMPLE F
SCALE: 1"=100'

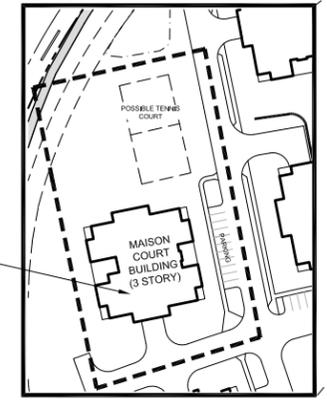


FLEXIBILITY EXAMPLE C
SCALE: 1"=100'

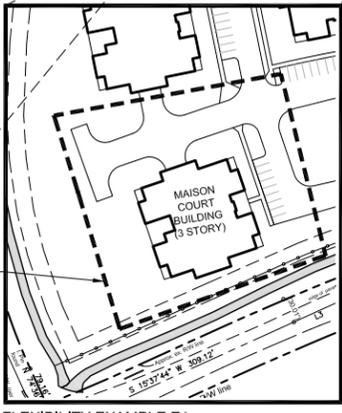

FLEXIBILITY EXAMPLE E1
SCALE: 1"=100'

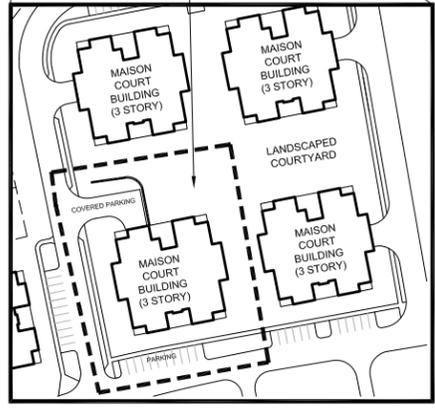

FLEXIBILITY EXAMPLE D
SCALE: 1"=100'

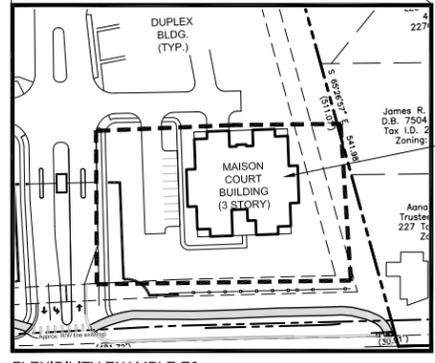

FLEXIBILITY EXAMPLE E2
SCALE: 1"=100'

NOTES:

- MINOR ADJUSTMENTS TO THE SITE PLAN MAY BE MADE, IN CONFORMANCE WITH SECTION 153.201(E) OF THE MATTHEWS ZONING ORDINANCE, AND THE "DEVELOPMENT STANDARDS" INCLUDED IN THIS PETITION.
- THIS PLAN SHOWS EXAMPLES OF POSSIBLE DEVELOPMENT ALTERNATIVES ALLOWED WITHIN THE DEVELOPMENT STANDARDS. IT DOES NOT REFLECT EVERY POSSIBLE VARIATION ALLOWED BY THE DEVELOPMENT STANDARDS.

No.	Date	By	REVISIONS TO OPTIONS REVISIONS PER TOWN & OWNER COMMENTS
1	08/03/12	SMW	ADDED SHEET
2	08/05/12	AMC	REVISIONS TO OPTIONS
3	11/02/12	AMC	REVISIONS PER TOWN & OWNER COMMENTS



Landworks
Design Group, P.A.
7521 Little Ave., Suite 111
Charlotte, NC 28226
704-841-1604 fax: 704-841-1604



FreemanWhite



**THE VILLAGE AT
PLANTATION ESTATES**
MATTHEWS, NC
REZONING APPLICATION #589

**PHASING
PLAN**

Project Manager: MDL

Drawn By: MDL, TMM


Checked By:

Date: 5/31/12


Project Number: 11015

Sheet Number:

ZP-04

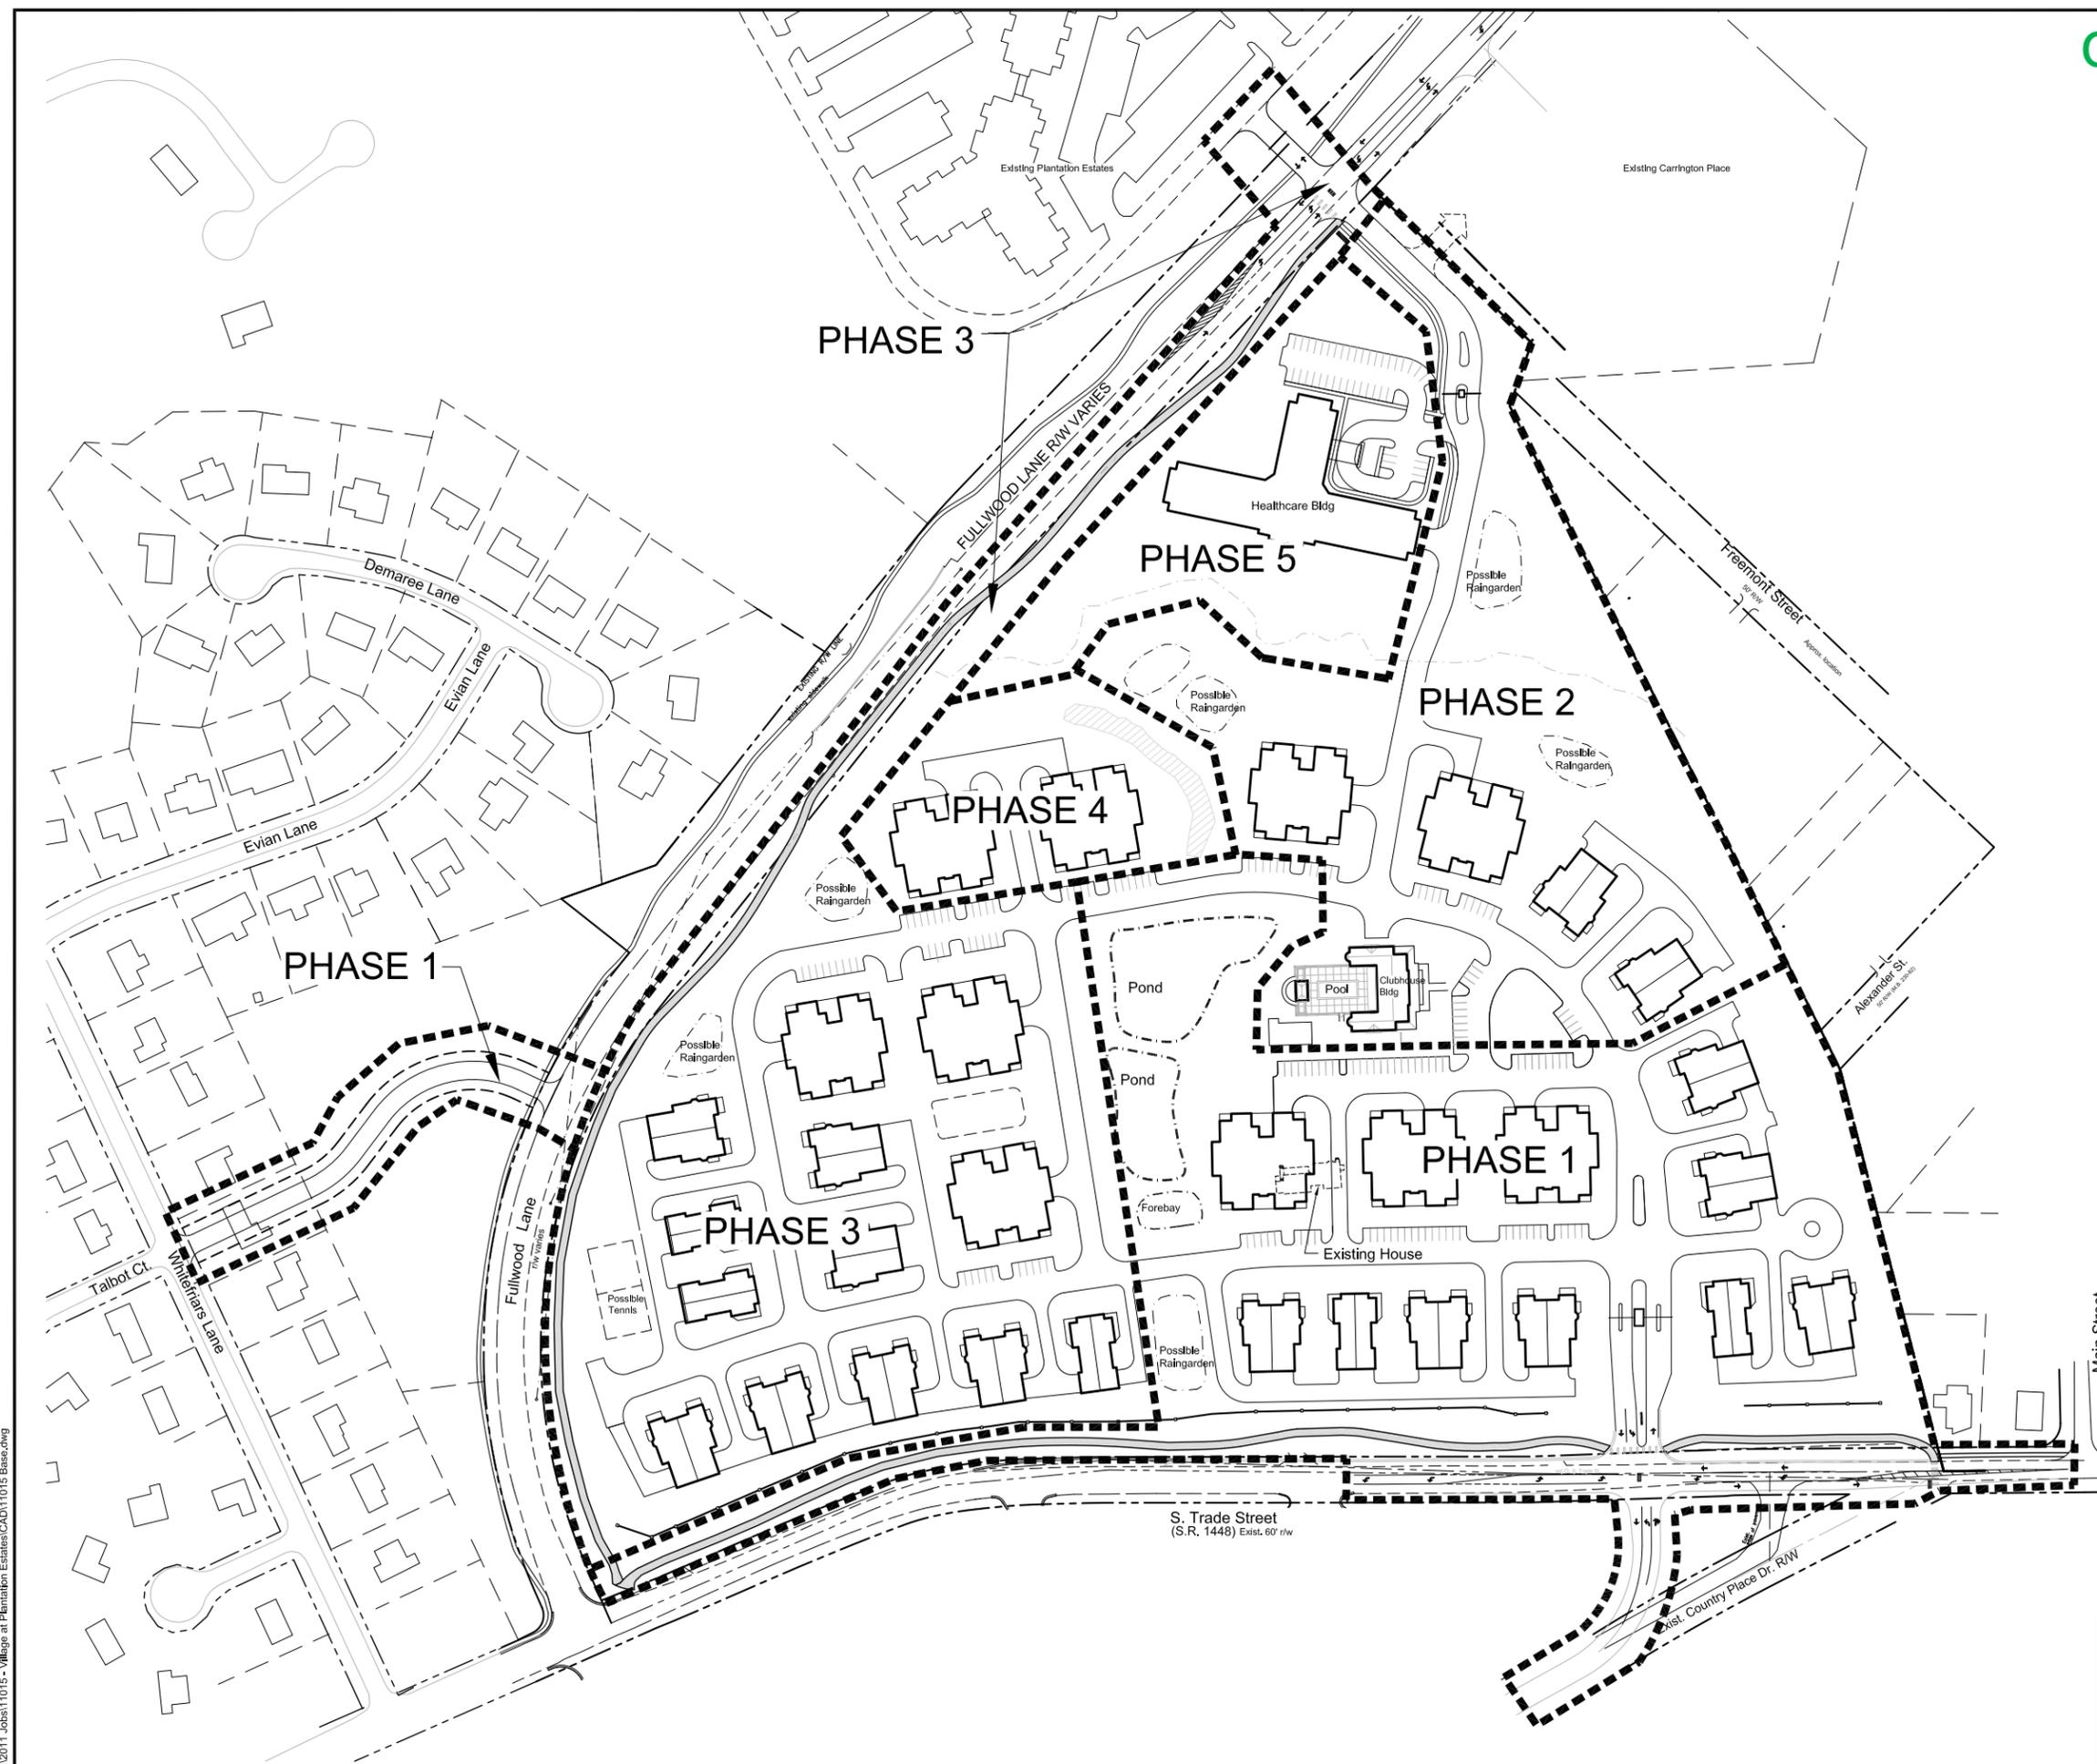

NOTES:
1. THE PHASING SHOWN ON THIS PLAN IS CONCEPTUAL, AND IS SUBJECT TO MODIFICATION BASED ON MARKET CONDITIONS, THE "DEVELOPMENT STANDARDS", AND OTHER SITE CONDITIONS.

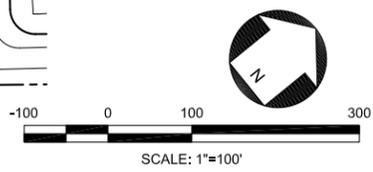


REVISIONS:

No.	Date	By	REVISIONS PER TOWN COMMENTS
1	08/03/12	SMW	REVISIONS PER TOWN COMMENTS
2	09/05/12	AMC	REVISIONS PER TOWN COMMENTS
3	11/02/12	AMC	REVISIONS PER TOWN & OWNER COMMENTS

P:\2011 Jobs\11015 - Village at Plantation Estates\CAD\11015 Base.dwg

CURRENT

2012-589
11/2/2012

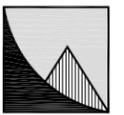

Landworks
Design Group, P.A.
7521 Little Ave., Suite 111
Charlotte, NC 28226
704-841-1604 fax: 704-841-1604



FreemanWhite



THE VILLAGE AT
PLANTATION ESTATES
MATTHEWS, NC
REZONING APPLICATION #589

TREE SAVE
PLAN

Project Manager: MDL

Drawn By: MDL/TMM

Checked By:

Date: 5/31/12

Project Number: 11015

Sheet Number:


ZP-05



Notes:
1. Tree protection/mitigation zones shown on this plan are conceptual, and are subject to adjustment during the construction document phase, as required to meet zoning ordinance requirements.

LEGEND


	existing deciduous tree
	existing coniferous tree
	tree protection zone
	tree save/mitigation zone

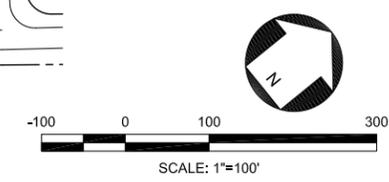


REVISIONS:

No.	Date	By	Comments
1	11/02/12	AMC	REVISIONS PER TOWN & OWNER COMMENTS

P:\2011 Jobs\11015 - Village at Plantation Estates\CAD\11015 Base.dwg

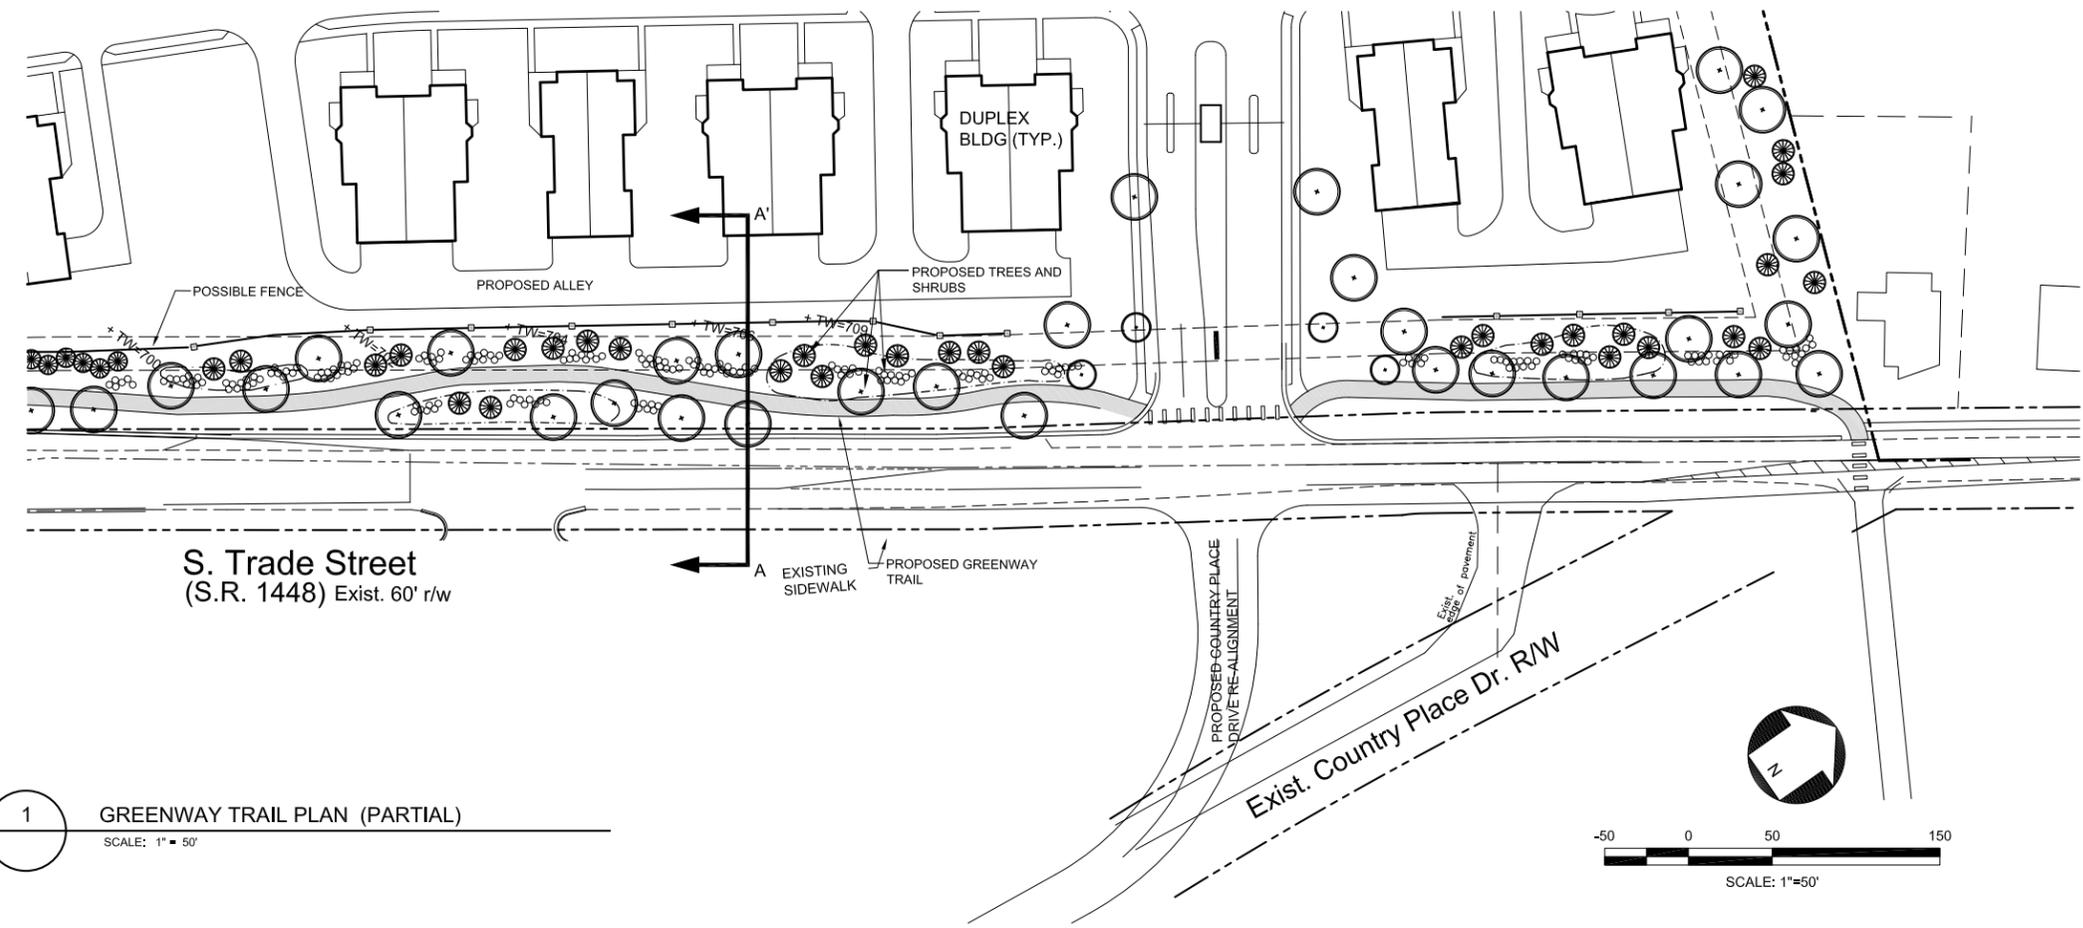

1 GREENWAY TRAIL PLAN (PARTIAL)
SCALE: 1" = 50'

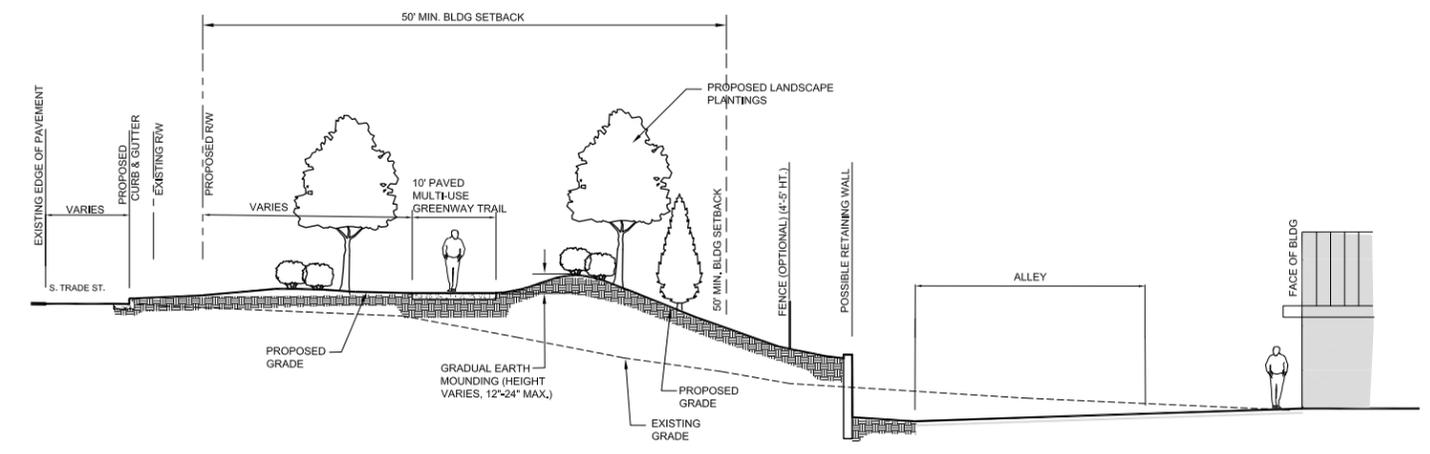

2 SECTION A - A' AT S. TRADE STREET
SCALE: 1/8" = 1'-0"

REVISIONS:

No.	Date	By	Description
1	8/3/12	SMW	MOVED ALL OF GREENWAY TRAIL TO NORTH SIDE OF TRADE ST.

P:\2011 Jobs\11015 - Village at Plantation Estates\CAD\11015 Base.dwg



Landworks
Design Group, P.A.
7621 Little Ave., Suite 111
Charlotte, NC 28226
704-841-1604 fax: 704-841-1604



FreemanWhite




**THE VILLAGE AT
PLANTATION ESTATES**
MATTHEWS, NC
REZONING APPLICATION #589

DETAILS


Project Manager: MDL
Drawn By: AMC
Checked By: TMM
Date: 5/31/12
Project Number: 11015

Sheet Number:


ZP-07

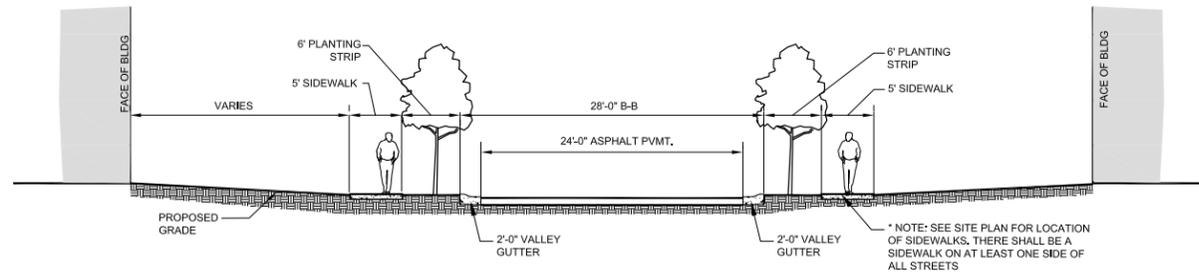


1 TYPICAL INTERNAL STREET TYPE 'A' (PRIVATE)
SCALE: 1/8" = 1'-0"

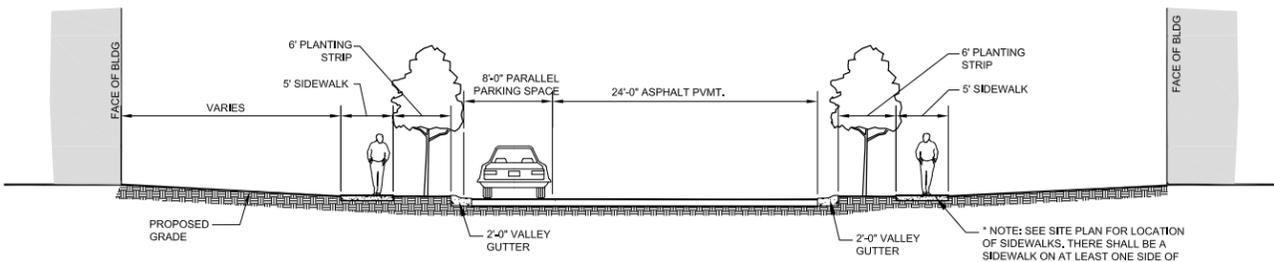

2 TYPICAL INTERNAL STREET TYPE 'A' WITH PARALLEL PARKING
SCALE: 1/8" = 1'-0"

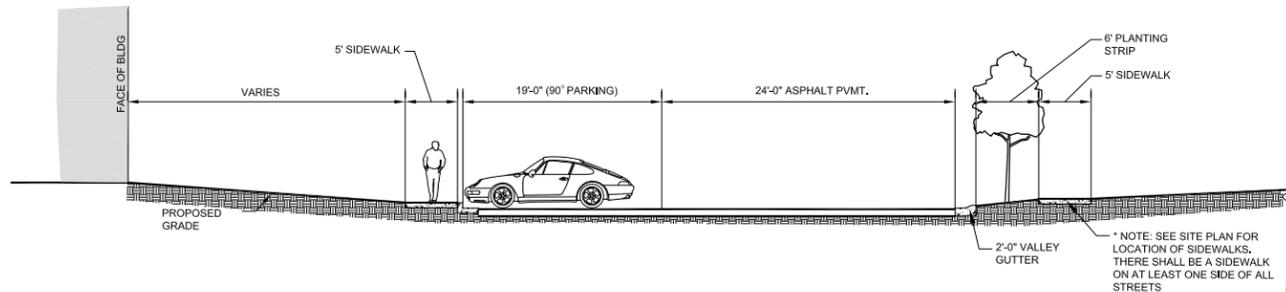

3 TYPICAL INTERNAL STREET TYPE 'A' WITH ANGLED PARKING (PRIVATE)
SCALE: 1/8" = 1'-0"

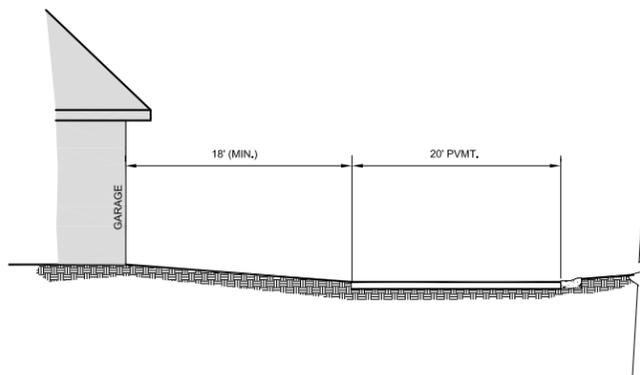

4 TYPICAL ALLEY (SERVING 5 OR MORE DUPLEX UNITS)
SCALE: 1/8" = 1'-0"

REVISIONS:

No.	Date	By



Landworks
Design Group, P.A.
P.O. Box 78060
Charlotte, NC 28271
704-841-1604 fax: 704-841-1604



FreemanWhite

ACTS
Retirement-Life
Communities®

**THE VILLAGE AT
PLANTATION ESTATES**
MATTHEWS, NC
REZONING PETITION # _____

**BUILDING
ELEVATIONS**

Project Manager: spc

Drawn By: spc

Checked By: spc

Date: 5/31/12

Project Number: 11015

Sheet Number:

ZP-08



1850 DUPLEX (STREET ELEVATION)
SCALE: 1/8" = 1'-0"



1850 DUPLEX (REAR ELEVATION) - SIDE ENTRY GARAGE OPTION
SCALE: 1/8" = 1'-0"



1850 DUPLEX (REAR ELEVATION) - FRONT ENTRY GARAGE OPTION
SCALE: 1/8" = 1'-0"



2050 DUPLEX (STREET ELEVATION)
SCALE: 1/8" = 1'-0"



2050 DUPLEX (REAR ELEVATION) - SIDE ENTRY GARAGE OPTION
SCALE: 1/8" = 1'-0"



2050 DUPLEX (REAR ELEVATION) - FRONT ENTRY GARAGE OPTION
SCALE: 1/8" = 1'-0"



CLUBHOUSE (POND SIDE ELEVATION)
SCALE: 1/8" = 1'-0"



CLUBHOUSE (STREET ELEVATION)
SCALE: 1/8" = 1'-0"

DRAWINGS ARE CONCEPTUAL AND ARE SUBJECT TO CHANGE

REVISIONS:

No.	Date	By



Landworks
Design Group, P.A.
P.O. Box 78060
Charlotte, NC 28271
704-841-1604 fax: 704-841-1604



FreemanWhite



THE VILLAGE AT
PLANTATION ESTATES
MATTHEWS, NC
REZONING PETITION # _____

BUILDING
ELEVATIONS

Project Manager: spc

Drawn By: spc

Checked By: spc

Date: 5/31/12

Project Number: 11015

Sheet Number:

ZP-09



MAISON COURT APARTMENT BUILDING (REAR ELEVATION)
SCALE: 1/8" = 1'-0"



MAISON COURT APARTMENT BUILDING (STREET ELEVATION)
SCALE: 1/8" = 1'-0"



HEALTHCARE BUILDING (FRONT ELEVATION)
SCALE: 3/32" = 1'-0"

No.	Date	By

DRAWINGS ARE CONCEPTUAL AND ARE SUBJECT TO CHANGE



Landworks
Design Group, P.A.
P.O. Box 78060
Charlotte, NC 28271
704-841-1604 fax: 704-841-1604



FreemanWhite

ACTS
Retirement-Life
Communities®

**THE VILLAGE AT
PLANTATION ESTATES**
MATTHEWS, NC
REZONING PETITION # 589

**DECORATIVE
WALL AND
SIGN
DETAILS**

Project Manager: spc

Drawn By: spc

Checked By: spc

Date: 8/3/12

Project Number: 11015

Sheet Number:

ZP-11

REVISIONS:

No.	Date	By
#1	8/3/12	SHEET ADDED




DRAWINGS ARE CONCEPTUAL AND ARE SUBJECT TO CHANGE

Development Standards:

- The development of the site will be controlled by the standards depicted on this site plan and by the Matthews Zoning Code to accommodate a Continuing Care Retirement Community in this R-1 (CD). The development will have independent living units, healthcare beds and their related accessory uses. No other uses that might be allowed in the R-1 district are proposed to be located on the project site. The density on the site will not exceed 10 dwelling units per acre. The site will include a variety of dwelling styles and sizes and may include small service uses as allowed by the provisions of Section 153.195 (A) (6) for the sole use and convenience of the residents, their guests, vendors and the staff.
- The development depicted on this site plan is intended to reflect the arrangement of proposed uses on the site, but the exact configuration, placement, and size of individual site elements may be altered or modified within the limits prescribed herein and by the Matthews Zoning Code during the design development and construction phases. Minor adjustments and amendments to the site plan may be considered so long as the Matthews Zoning Code, the overall concept for the site, and the conditions of the site plan are preserved. Additional changes and modifications of the site plan may be proposed that are in conformance with the provisions of Section 153.201(E) of the Matthews Zoning Code.
- At no time will the total number of independent living units on the site exceed 300. The petitioner reserves the right to modify the number of each individual unit type based on market conditions. Additionally, at no time will the total number of assisted living beds and/or skilled nursing beds exceed 140. The site may also include a resident clubhouse with offices, wellness center, and bistro. It may also contain a maintenance building, gatehouse and other site amenities. For each building type listed below, the established limits will not be exceeded. The Petitioner will limit the height of any buildings located within 100'-0" of the Freemont Street property line between South Trade Street and Fullwood Lane to two-stories (35'-0") above grade.
- The maximum square footage of each single family home (simplex) will not exceed 3,000 square feet, exclusive of the garage; two-family home (duplex) will not exceed 6,000 square feet, exclusive of the garage; and three-family home (triplex) will not exceed 9,000 square feet, exclusive of the garage. The maximum combined square footage of these homes will not exceed 300,000 square feet. These homes will have up to four bedrooms and each individual unit will have a one or two car garage. The maximum number of each home type is 70 simplex buildings or 70 living units, 50 duplex buildings or 100 living units, and 30 triplex buildings or 90 living units. These homes will be up to one and a half stories high and will not exceed 35 feet, as measured per the Matthews Zoning Code.
- The maximum square footage of each apartment building will not exceed 60,000 square feet, exclusive of the garage. The maximum combined square footage of these apartment buildings will not exceed 825,000 square feet. These apartments will have up to three bedrooms on up to three levels of residential floors and may include under-building/ground garages. These apartment buildings will be up to four stories in height and include up to 24 living units per building. These apartment buildings will not exceed 270 total living units. The maximum height of the apartment buildings will not exceed 60 feet, as measured per the Matthews Zoning Code.
- The maximum square footage of the resident clubhouse building will not exceed 30,000 square feet. This building may include administration offices, meeting facilities, kitchen and dining facilities, swimming pools, exercise spaces, maintenance shops, apartments and other ancillary services. This building will be up to four stories in height and may include under-building/ground garages. The maximum height of this building will not exceed 60 feet, as measured per the Matthews Zoning Code.
- The maximum square footage of the skilled nursing/assisted living buildings will not exceed 150,000 square feet exclusive of the garage, and will not exceed 140 beds. These buildings will be up to four stories in height. The maximum height of the skilled nursing/assisted living buildings will not exceed 60 feet, as measured per the Matthews Zoning Code.
- The Petitioner has provided building elevations for the structures to be constructed on the site. The building illustrations that are included with this petition are intended to reflect the general mass, scale, configuration, and the architectural character of the buildings. The Petitioner may make revisions to the design and materials of the buildings so long as the general mass, scale, configuration, and architectural character of the buildings are maintained in accordance with the Matthews Zoning Code.
- Brick or stone will be used on a minimum of 50% of each building elevation that fronts upon either an exterior public street or internal private street. Each elevation may also incorporate additional masonry materials such as decorative block. A minimum of 30% of each elevation that fronts upon either an exterior public street or internal private street may be clad in cement-plank siding. A maximum of 15% of each elevation that fronts upon either an exterior public street or internal private street may be of exterior insulation finish system or stucco. Should the percentage of brick or stone exceed 50%, the minimum percentage required for cement-plank siding will not apply. These requirements do not apply to enclosed walkways, windows, doors, soffits, gable ends and/or other architectural treatments, nor shall they apply to detached garages. Detached garages, however, will be constructed in a manner and with materials that will complement the associated home or apartment building. Additional materials used on the site include, but are not limited to asphalt or fiberglass shingles or metal on mansard and pitched roofs, and membrane roof systems on flat roofs.
- This development will be constructed in phases subject to modifications based on market conditions and other site conditions. Transportation improvements contained herein will be incorporated into the site phase development process as the various portions of the site are developed. To coordinate with construction of proposed roadway improvement projects planned by the Town of Matthews, the Petitioner reserves the right to provide payment in lieu of the construction of curb and gutter along portions of South Trade Street and Fullwood Lane.
- The Petitioner shall work with Matthews United Methodist Church and the Town of Matthews to relocate Country Place Drive through the Church's property to align with the main entrance into the site. The Petitioner will bear all reasonable cost of the construction of these improvements as well as the reasonable cost of a traffic signal either when warranted or approved by the appropriate governing body having jurisdiction over the road. A pedestrian signal will be installed where the greenway crosses South Trade Street at this time. These improvements will be installed as a part of Phase I, except the signal installation may come at a later date as approval is obtained. However, a pedestrian signal will be installed where the greenway crosses South Trade Street as part of Phase I.

- Upon approval of this rezoning petition, the Petitioner intends to unilaterally donate or provide to the Town of Matthews a 100 year lease at \$1.00 per year for Tax Parcel # 22715201 (located west of Fullwood Lane), for exclusive use by the Town of Matthews for municipal purposes.
- Parking will be provided in accordance with the Matthews Zoning Code Section 153.117 Schedule of Off-Street Parking. Parking will be provided in garages associated with each simplex/duplex/triplex home. Parking will be provided in under-building/ground garages where subsurface conditions allow, surface lots and on-street parking areas for each apartment building. The Petitioner reserves the right to also provide on-street pull-in and parallel parking spaces on the internal private streets in addition to the parking spaces shown on the site plan. The Parking Plan required by Section 153.123 of the Matthews Zoning Code will be submitted as a separate document from this Rezoning Petition with each site phase.
- Signage will be permitted in accordance with the Matthews Zoning Code Section 153.150. Detached signage will be limited to ground mounted monument signs that will identify the development at each public street vehicular access road limited to 40 square feet in area for each sign. It is the intent of the petitioner to locate signage at/near the main entrance on South Trade Street and at/near the entrance at Fullwood Lane as permitted by the Schedule of Sign Regulations. The materials of these signs will be compatible with the materials used to construct the buildings on the site. The Internal directional signage may also be utilized on either a temporary or permanent basis. The Master Sign Plan required by Section 153.149 of the Matthews Zoning Code will be submitted as a separate document from this Rezoning Petition.
- Fire Department site access will be provided by a driveway connection at South Trade Street and a driveway connection at Fullwood Lane. Temporary emergency access may be provided from Fullwood Lane due to the phasing of the site development. The Petitioner reserves the right to provide vehicle and pedestrian gates at both of these access points. All gates will be accessible by emergency services per the Town of Matthews Ordinance. There will not be an internal street connection with Freemont Street.
- The site will be designed and constructed to comply with the Town of Matthews Fire Department Standards. Fire Hydrant locations will be provided in compliance with the NC State Fire Code. All stream crossings and emergency service roads or pathways will be built to withstand loads of 80,000 pounds and an 8 foot wheel base.
- The apartment buildings and garages will be equipped with fire alarm systems and automatic sprinkler systems as required by the NC State Building Code.
- The Petitioner will install a 10 foot wide greenway trail with pedestrian lighting on the edge of the property along South Trade Street in Phase I of the site development. A 5 foot sidewalk will be installed on the edge of the property along Fullwood Lane, as generally indicated on the Site Plan in Phase III of the site development. The exact path of the greenway trail will be determined during the development review and approval process. The Petitioner will provide a greenway access and use easement on its property for any portion of the greenway trail indicated on the site plan that is outside of the public street right-of-way. The Petitioner reserves the right to provide payment in lieu of the construction of the greenway trail due to the future construction of the proposed roadway projects along South Trade Street and Fullwood Lane. The Petitioner will install an internal sidewalk system that will connect the units on the site with the greenway and sidewalks on the adjacent public streets.
- The Petitioner will dedicate up to an additional 15 feet of right-of-way along Fullwood Lane and South Trade Street, measured from existing street right-of-way lines, within 400 feet of the intersection of Fullwood Lane and South Trade Street, as required to accommodate future Town of Matthews road projects in the vicinity of the site. The Petitioner reserves the right to provide payment in lieu of the construction of the curb and gutter and sidewalks due to the future construction of the proposed roadway projects along South Trade Street and Fullwood Lane. Any public pathways and sidewalks located around the perimeter of the site shall be enclosed in a pedestrian access easement in any areas where said pathways leave the public right of way.
- The Petitioner will install 30 foot wide streetscape landscape areas along Fullwood Lane and South Trade Streets, as generally indicated on the site plan and measured from the street right of ways. No buildings or parking will be placed within these landscape areas. Existing trees and shrubs preserved within these areas may be used to meet the landscape requirements of the Ordinance. Additionally, new trees and shrubs may be added to these landscape areas as required to meet Zoning Ordinance requirements. Landscaped berms, sidewalks, and/or greenway trails may be installed within these landscape areas. The Petitioner reserves the right to selectively clear underbrush, invasive weeds, and poison ivy within the 30 foot landscaped areas in accordance with the Ordinance.
- The Petitioner will install 30 foot wide perimeter landscape areas along the project perimeter adjacent to existing residential development, as generally indicated on the site plan. No buildings, parking, or detention ponds will be placed within these landscape areas. Existing trees and shrubs will be preserved within these perimeter areas whenever practical. Additionally, new trees and shrubs may be added to these landscape areas to meet Town of Matthews Zoning Ordinance requirements. The Petitioner reserves the right to selectively clear underbrush, invasive weeds, and poison ivy within the 30 foot landscape areas in accordance with the Ordinance.
- The Petitioner may install fencing and/or screen walls along the perimeter of the site, provided that fencing or screen walls shall be no closer than 15 feet to any exterior property line. Entry signage and associated decorative walls may be closer to street right of ways, subject to Ordinance requirements. Finish materials of the fences or walls may include brick, stone, EIFS or comparable, decorative metal, aluminum, manufactured wood and wood. The finished side of fencing/screen walls shall face outward from the property.
- Approximate tree save areas are shown on the Tree Protection Plan. The Petitioner may supplement the existing trees per Ordinance guidelines. The Petitioner also reserves the right to provide tree planting mitigation (replanting) in accordance with the Town of Matthews Ordinance guidelines.
- The minimum unobstructed open space for the site is 50% in conformance with Section 153.195 of the Matthews Zoning Code at Table 1 for Continuing Care Retirement Communities.
- All outdoor lighting shall comply with the Matthews Zoning Code. No open lens lighting will be installed, but architectural lighting on building facades and landscape areas will be permitted.

- The Petitioner reserves the right to demolish the existing brick wall along South Trade Street to install road improvements, greenway trails/sidewalks, and/or landscape improvements. The existing concrete monument will be donated to the Town of Matthews for reuse at an off-site location.
- There is an existing pond on the site. The Petitioner may, during the construction of the site, drain, clean and redesign this pond to better accommodate storm water and develop a more attractive open space and open space amenity. As a result, the final location and dimensions of the pond may be modified during construction.
- Project wide water quality features, including storm water detention facilities, will be designed to meet the applicable standards of the Town of Matthews, including the Phase 2 controls (post- construction) standards.
- SWIM buffers will be provided in accordance with the Mecklenburg County Ordinance requirements.
- Throughout this Rezoning Petition, the terms "Owner", "Owners", "Petitioner" or "Petitioners", shall, with respect to the Site, be deemed to include the heirs, devisees, agents, personal representatives, successors in interested and assignees of the owner or owners of the Site who may be involved in its development from time to time.
- The Petitioner will install a 5 foot wide sidewalk along South Trade Street in front of the two existing adjacent house lots from the ACTS property line toward Main Street.
- The Petitioner will bear the cost of a traffic signal at the Fullwood Lane driveway entrance when approved by the appropriate governing body having jurisdiction over the road. This improvement will be installed as a part of Phase III or at the time the Fullwood Lane driveway is constructed.
- The Petitioner will pay property taxes in a manner similar to the taxes paid by Plantation Estates to the Town of Matthews and the County of Mecklenburg even though the Village at Plantation Estates is a not-for-profit 501(c)(3) entity and even if the Continuing Care Retirement Community might otherwise be fully or partially exempted from the payment of any such taxes. As such, the Petitioner reserves all rights and privileges accorded to any other property tax payer. This may be accomplished through use of a Payment in Lieu of Taxes program or such other method as mutually agreed upon.

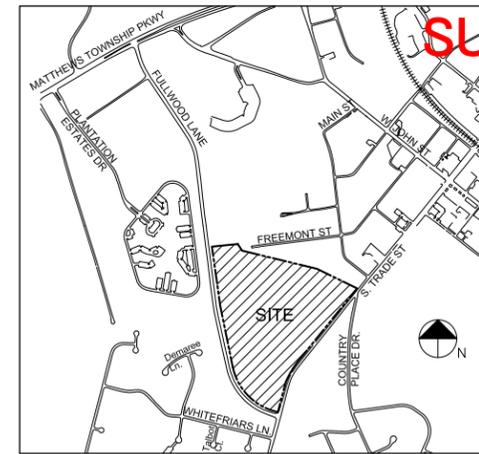

VICINITY MAP
NOT TO SCALE

SUPERSEDED

2012-589
8/8/2012

COMBINED MAXIMUM UNIT COUNT & MINIMUM PARKING SPACE TABLE:

Matthews Zoning Code Section 153.117 Schedule of Off-Street Parking requires 1.1 parking spaces per each Independent Living Unit and 1 space for every 4 patient beds (.25) in the Healthcare Nursing Home or Home for the Aged, plus 1 space for every 2 staff on the shift of greatest staff employment. "Total Parking Provided" will include +15% of "Total Required Parking" for the Visitors in each phase:

	Max. Units	Min. Parking
Total Independent Living Units (Simplex/Duplex/Triplex/Apartment):	300	330
Total Healthcare Building Beds (Assisted Living/Skilled Nursing):	140	35
Total Combined Independent + Healthcare Units / Staff (50) Parking:	440	25
Total Parking Required: Independent Living + Healthcare + Staff:		390
Total Proposed Village at Plantation Estates Visitor Parking (15%):		60
Total Parking Provided: Independent + Healthcare + Staff + Visitors:		450

SITE DATA

TAX PARCELS:	22715125, 22715124, 22715122, 22715113 22715112, 22715121, 22715114, 22715123
SITE AREA:	APPROXIMATELY 44.88 ACRES (GROSS)
EXISTING ZONING:	R4 (CD)
PROPOSED ZONING:	R4 (CD)

SHEET SCHEDULE

ZP-00	COVER SHEET
ZP-01	EXISTING CONDITIONS PLAN
ZP-02	GRAPHIC SITE PLAN
ZP-03	SITE LAYOUT PLAN
ZP-03A	ALTERNATE SITE LAYOUT PLAN
ZP-04	PHASING PLAN
ZP-05	TREE SAVE PLAN
ZP-06	GREENWAY TRAIL DETAILS
ZP-07	DETAILS
ZP-08	BUILDING ELEVATIONS
ZP-09	BUILDING ELEVATIONS
ZP-10	FULLWOOD LANE & S. TRADE STREET ROAD IMPROVEMENTS
ZP-11	DECORATIVE WALL & SIGN DETAILS

REVISIONS:

No.	Date	By	
1	8/3/12	SMW	REVISIONS PER TOWN COMMENTS



Landworks
Design Group, P.A.
7621 Little Ave., Suite 111
Charlotte, NC 28226
704-841-1604 fax: 704-841-1604



FreemanWhite



THE VILLAGE AT
PLANTATION ESTATES
MATTHEWS, NC
REZONING APPLICATION #589

COVER
SHEET

Project Manager: MDL

Drawn By: MDL, TMM

Checked By:


Date: 5/31/12

Project Number: 11015

Sheet Number:

ZP-00

SUPERSEDED 2012-589
8/8/2012

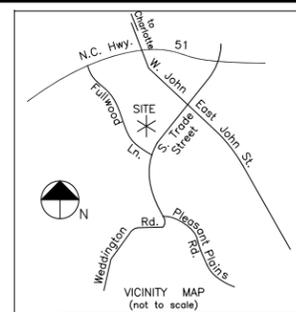

LEGEND

ch.	chord
LR	curve length & radius
s.f.	square feet (by coordinates)
IPS	iron pin set
conc.	concrete
a/c	air conditioner
MB, DB	record map and deed references
⊙	light pole
⊕	utility pole
⊖	gas valve
⊗	guy anchor
⊘	catch basin
⊙	water meter
⊙	water valve
⊙	fire hydrant
⊙	sanitary sewer manhole
⊙	sanitary sewer clean-out
⊙	deciduous tree
⊙	coniferous tree
⊙	telephone manhole
⊙	electric manhole
⊙	underground gas line
⊙	sanitary sewer manhole
⊙	temporary bench mark
T.B.M.	temporary bench mark
-T-	underground telephone line
-W-	water line
-SS-	sanitary sewer line
-UE-	underground electric
-OE-	overhead electric
-X-	fence line
-RCP-	reinforced concrete pipe
-CMP-	corrugated metal pipe
I.E.	invert elevation
X	spot elevation

NOTE:
1. EXISTING CONDITIONS ARE FROM A SURVEY BY A.S. ZOUTEVILLE, P.A., DATED 04-08-08, LATEST REVISION 09-15-08.
2. SITE SOIL TYPE IS PRIMARILY CECIL, WITH AREAS OF ENON, MECKLENBURG, HELENA & LIGNUM.

Landworks
Design Group, P.A.
7621 Little Ave., Suite 111
Charlotte, NC 28226
704-841-1604 fax: 704-841-1604

Single Source
DESIGN BUILD

FreemanWhite

ACTS Retirement-Life Communities*

**THE VILLAGE AT
PLANTATION ESTATES**
MATTHEWS, NC
REZONING APPLICATION #589

**EXISTING
CONDITIONS
PLAN**

Project Manager: MDL

Drawn By: MDL, TMM


Checked By:

Date: 5/31/12

Project Number: 11015

Sheet Number:

ZP-01

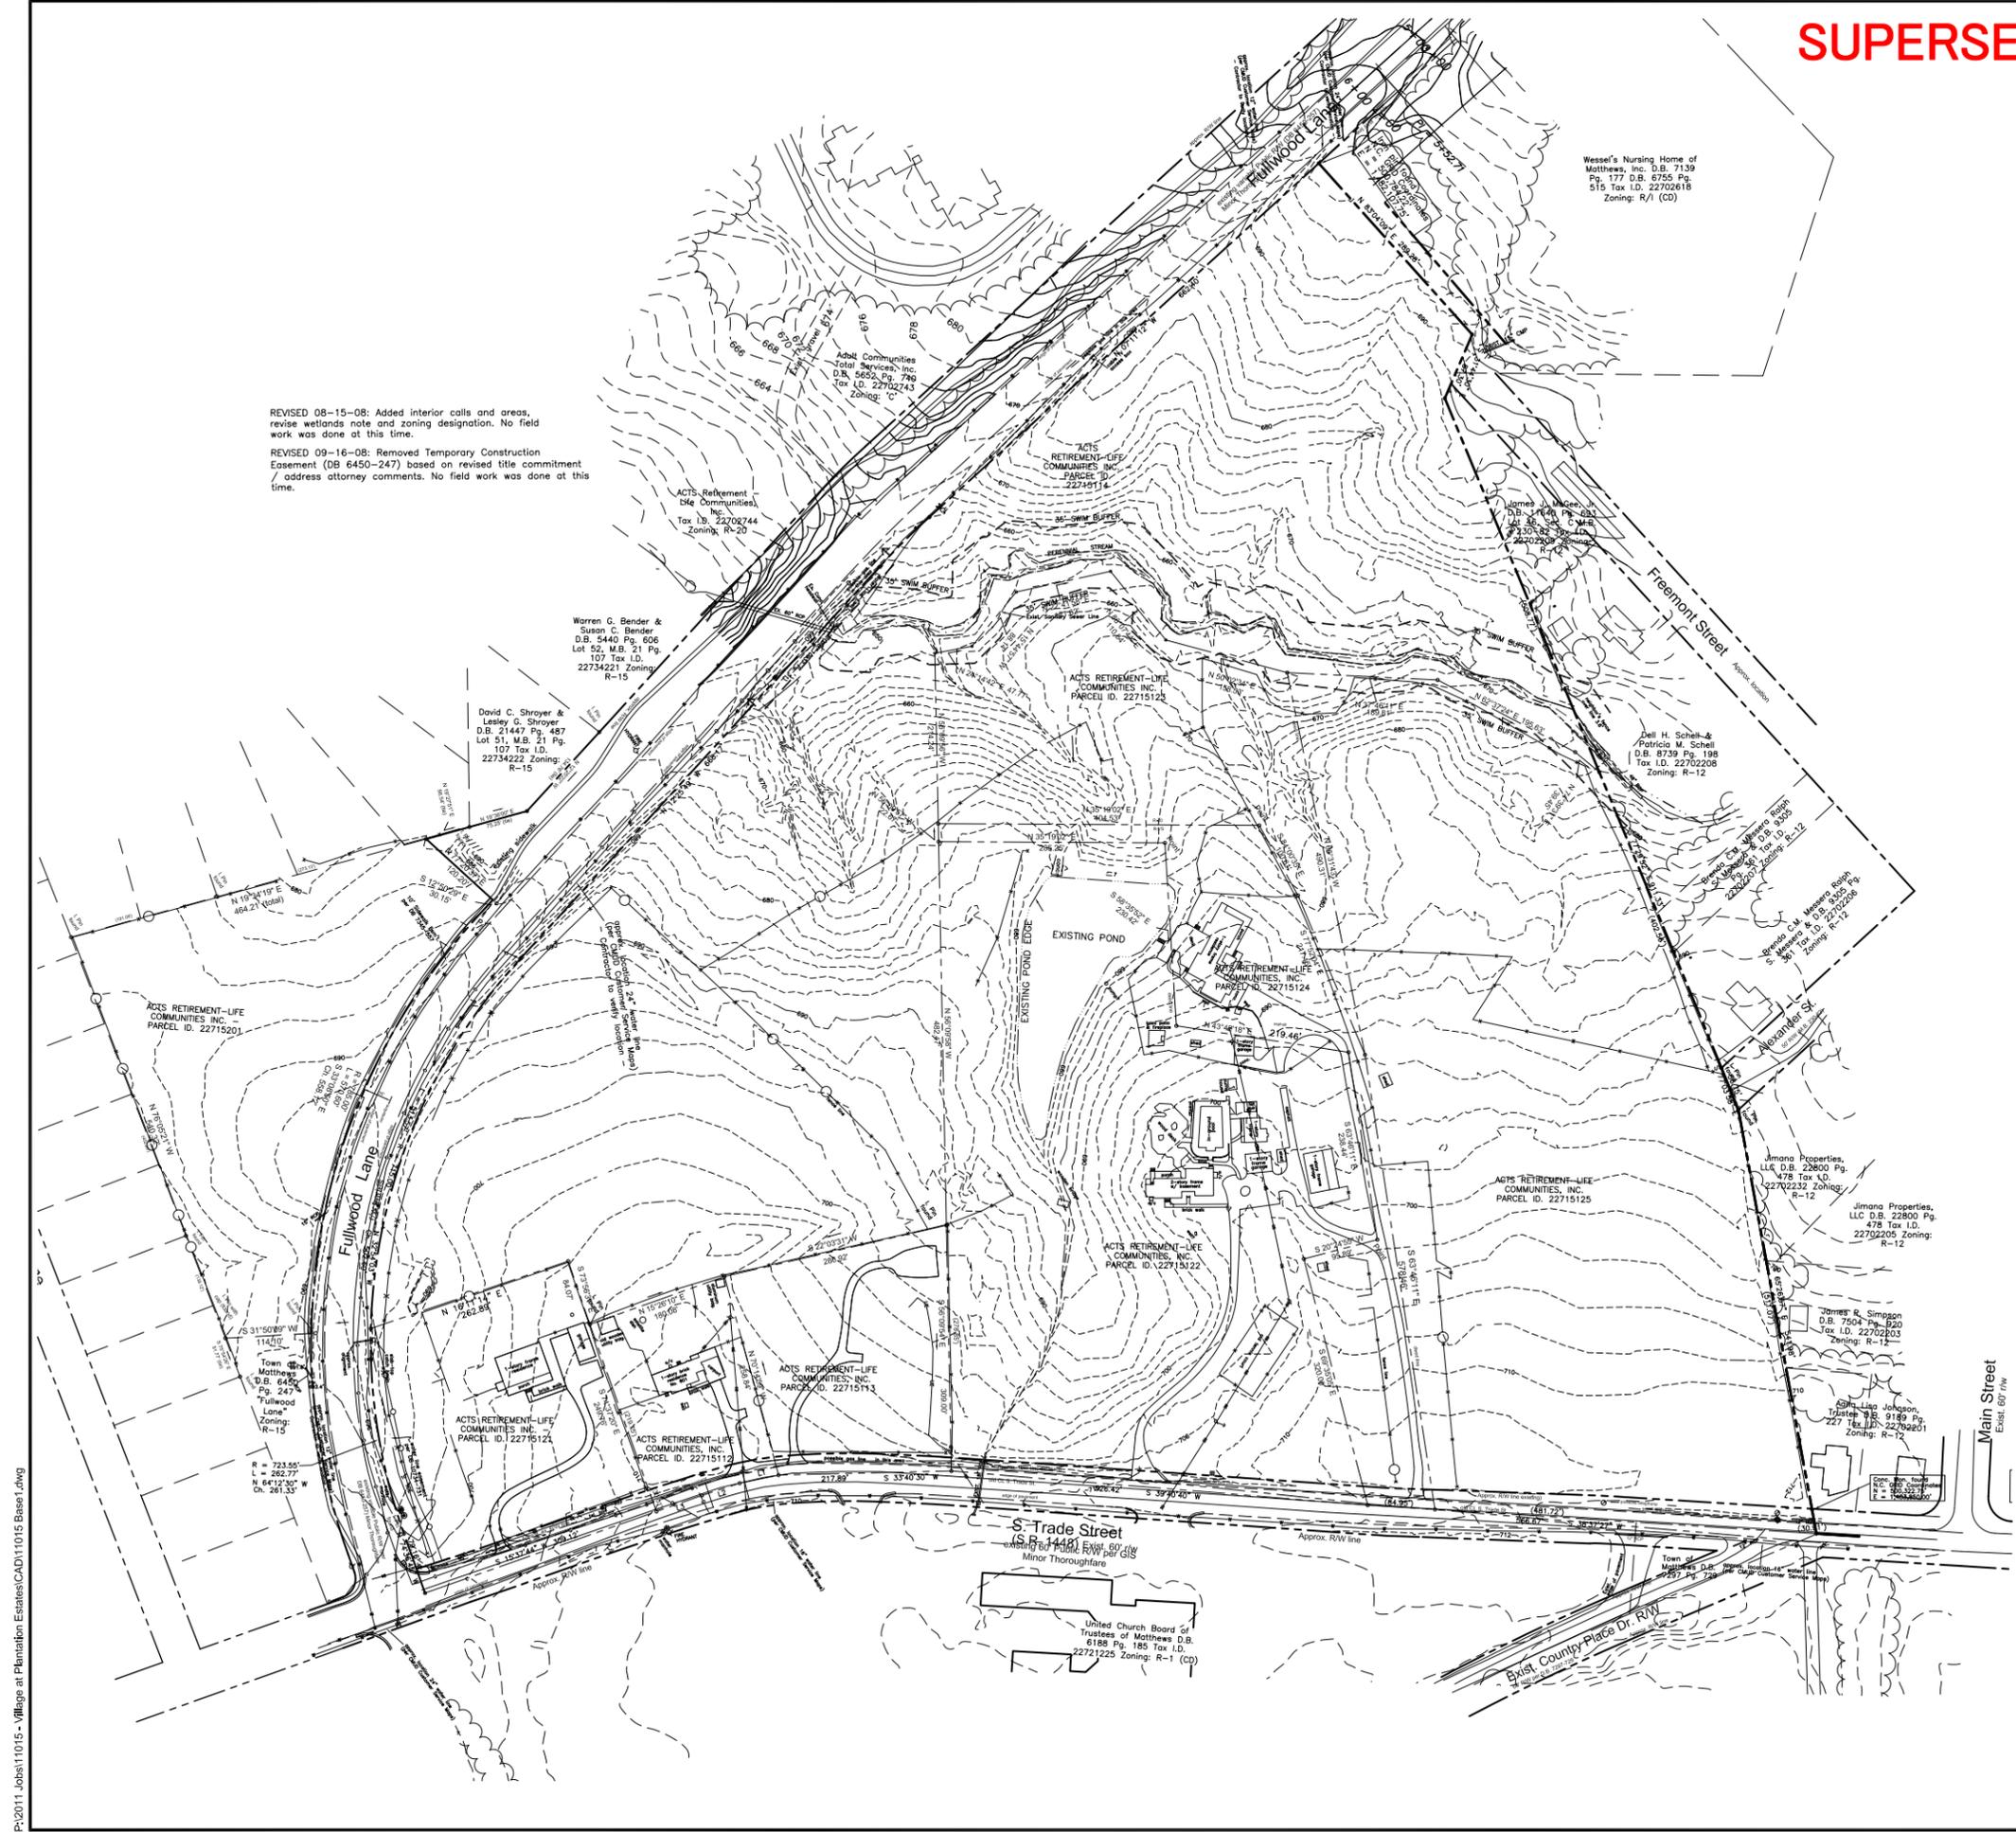

REVISED 08-15-08: Added interior calls and areas, revise wetlands note and zoning designation. No field work was done at this time.

REVISED 09-16-08: Removed Temporary Construction Easement (DB 6450-247) based on revised title commitment / address attorney comments. No field work was done at this time.

ACTS Retirement-Life Communities, Inc.
Parcel ID: 22702744
Zoning: R-20

Warren C. Bender & Susan C. Bender
D.B. 5440 Pg. 606
Lot 52, M.B. 21 Pg. 107
Tax ID: 22734222 Zoning: R-15

David C. Shroyer & Lesley G. Shroyer
D.B. 21447 Pg. 487
Lot 51, M.B. 21 Pg. 107
Tax ID: 22734222 Zoning: R-15

Pg. 177 D.B. 6755 Pg. 515
Tax ID: 22702618
Zoning: R/1 (CD)

ACTS Retirement-Life Communities, Inc.
Parcel ID: 22715124

Dell H. Scheil & Patricia M. Scheil
D.B. 8739 Pg. 198
Tax ID: 22702208
Zoning: R-12


Jimano Properties, LLC D.B. 22800 Pg. 478
Tax ID: 22702232 Zoning: R-12

Jimano Properties, LLC D.B. 22800 Pg. 478
Tax ID: 22702205 Zoning: R-12

James R. Simons D.B. 7504 Pg. B20
Tax ID: 22702203 Zoning: R-12

APRILIA JOHNSON, Trustee D.B. 9189 Pg. 227
Tax ID: 22702201 Zoning: R-12

United Church Board of Trustees of Matthews D.B. 6188
Zoning: R-1 (CD)

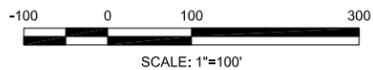

REVISIONS:

No.	Date	By

P:\2011 Jobs\11015 - Village at Plantation Estates\CAD\11015 Base1.dwg

SUPERSEDED 2012-589
8/8/2012



Landworks
Design Group, P.A.
7821 Little Ave., Suite 111
Charlotte, NC 28226
704-841-1604 fax: 704-841-1604



FreemanWhite



**THE VILLAGE AT
PLANTATION ESTATES**
MATTHEWS, NC
REZONING APPLICATION #589

**GRAPHIC
SITE PLAN**

Project Manager: MDL

Drawn By: MDL, TMM

Checked By:

Date: 05/31/12

Project Number: 11015

Sheet Number:

ZP-02



P:\2011 Jobs\11015 - Village at Plantation Estates\CAD\11015 Base1.dwg

REVISIONS:

No.	Date	By



Landworks
Design Group, P.A.
7621 Little Ave., Suite 111
Charlotte, NC 28226
704-841-1604 fax: 704-841-1604



**THE VILLAGE AT
PLANTATION ESTATES**
MATTHEWS, NC
REZONING APPLICATION #589

**SITE
LAYOUT
PLAN**

Project Manager: MDL

Drawn By: MDL, TMM


Checked By:

Date: 05/31/12

Project Number: 11015

Sheet Number:

ZP-03

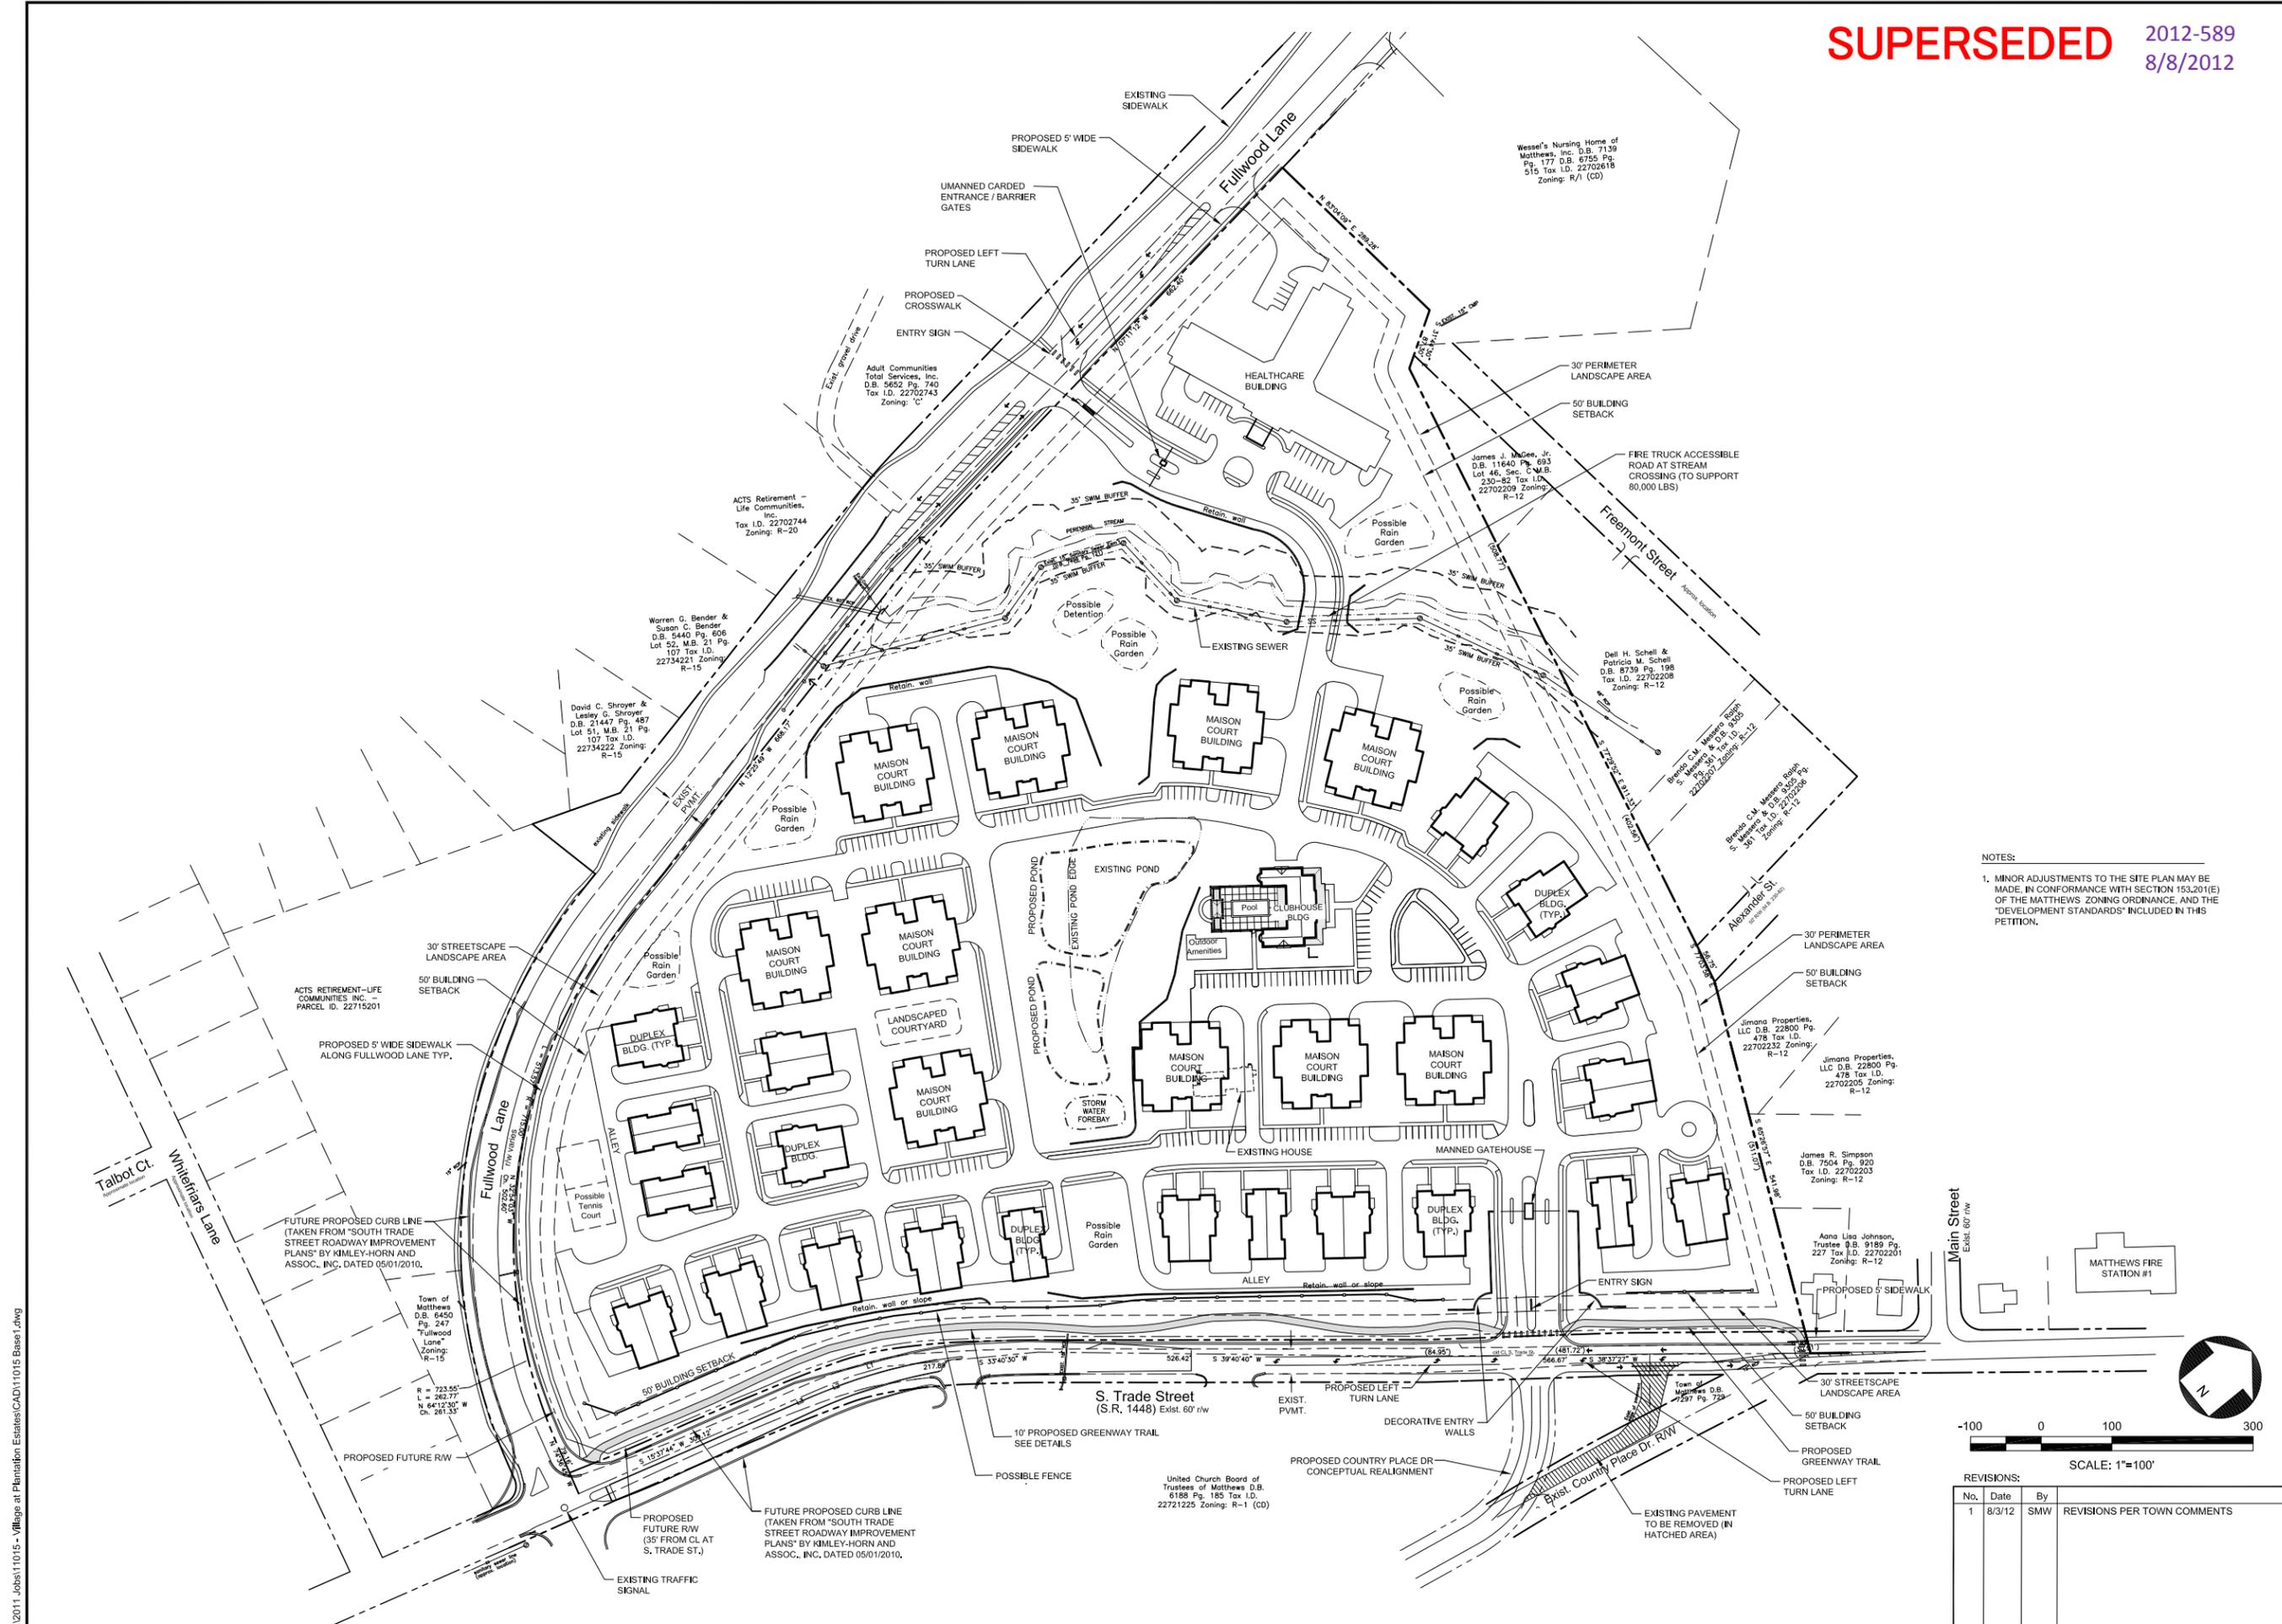

NOTES:
1. MINOR ADJUSTMENTS TO THE SITE PLAN MAY BE MADE IN CONFORMANCE WITH SECTION 153.201(E) OF THE MATTHEWS ZONING ORDINANCE, AND THE "DEVELOPMENT STANDARDS" INCLUDED IN THIS PETITION.

REVISIONS:			
No.	Date	By	REVISIONS PER TOWN COMMENTS
1	8/3/12	SMW	

P:\2011 Jobs\11015 - Village at Plantation Estates\CAD\11015 Base.dwg



Landworks
Design Group, P.A.
7621 Little Ave., Suite 111
Charlotte, NC 28226
704-841-1604 fax: 704-841-1604



**THE VILLAGE AT
PLANTATION ESTATES**
MATTHEWS, NC
REZONING APPLICATION #589

**ALTERNATE
SITE
LAYOUT
PLAN**

Project Manager: MDL

Drawn By: MDL, TMM


Checked By:

Date: 08/3/12


Project Number: 11015

Sheet Number:


ZP-03A

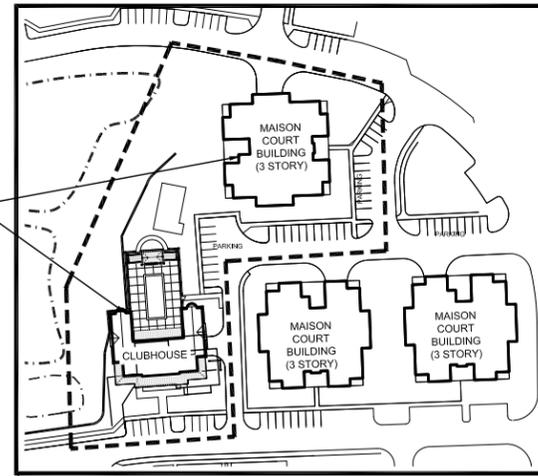

FLEXIBILITY EXAMPLE A
SCALE: 1"=100'

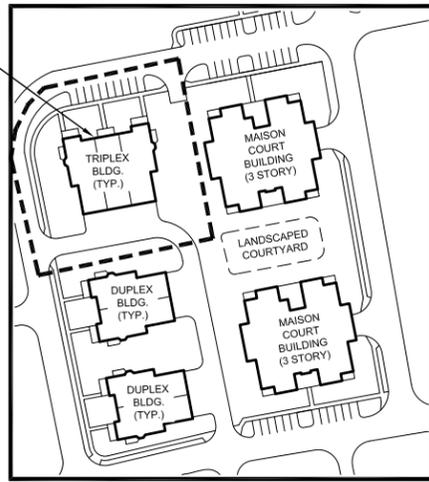


FLEXIBILITY EXAMPLE B
SCALE: 1"=100'

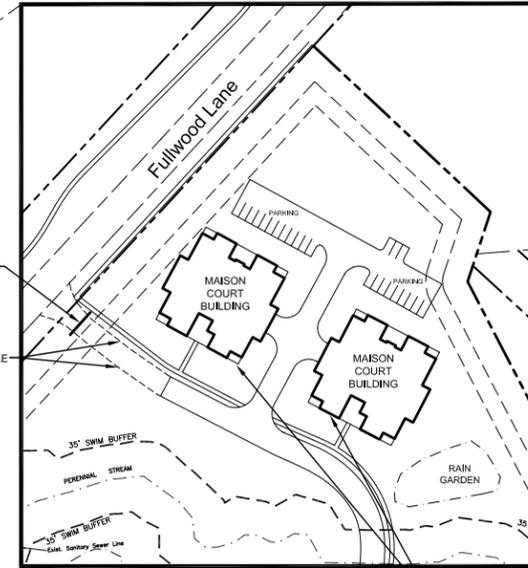


FLEXIBILITY EXAMPLE G
SCALE: 1"=100'


2 MAISON COURT BUILDINGS IN OUTLINED AREA (INSTEAD OF HEALTHCARE BUILDING)

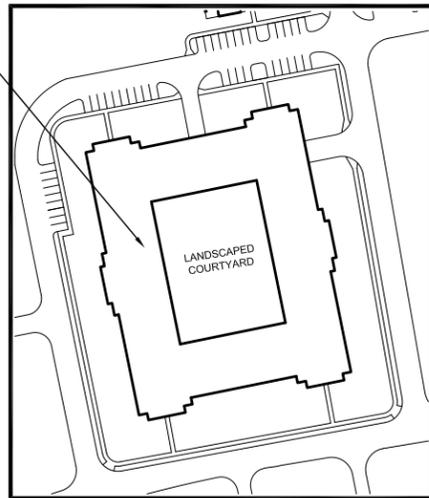


FLEXIBILITY EXAMPLE B1
SCALE: 1"=100'

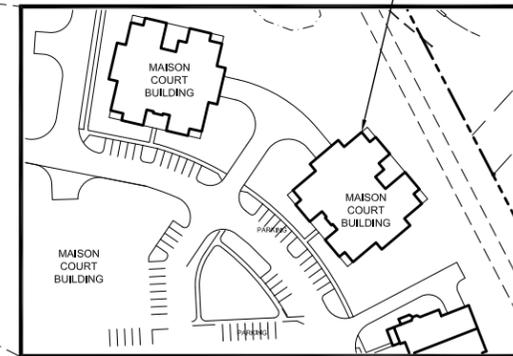


FLEXIBILITY EXAMPLE F
SCALE: 1"=100'

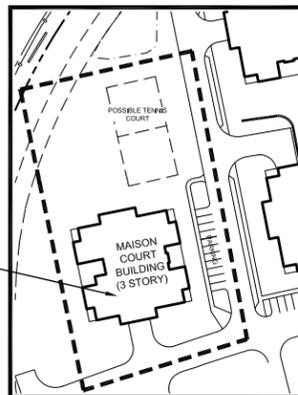


FLEXIBILITY EXAMPLE C
SCALE: 1"=100'

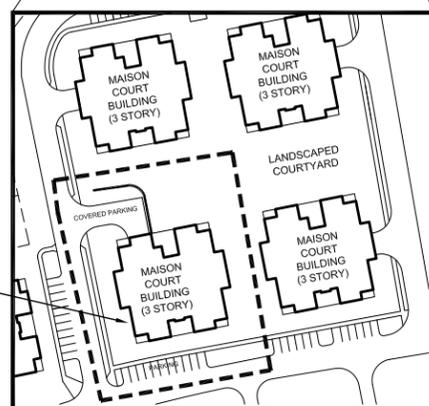

FLEXIBILITY EXAMPLE D
SCALE: 1"=100'

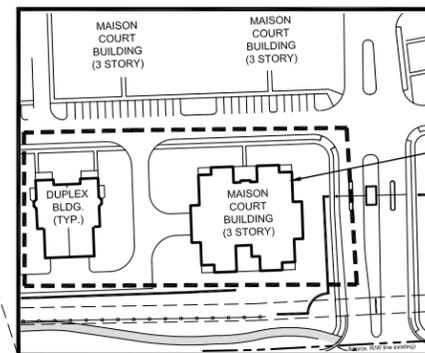

FLEXIBILITY EXAMPLE E
SCALE: 1"=100'

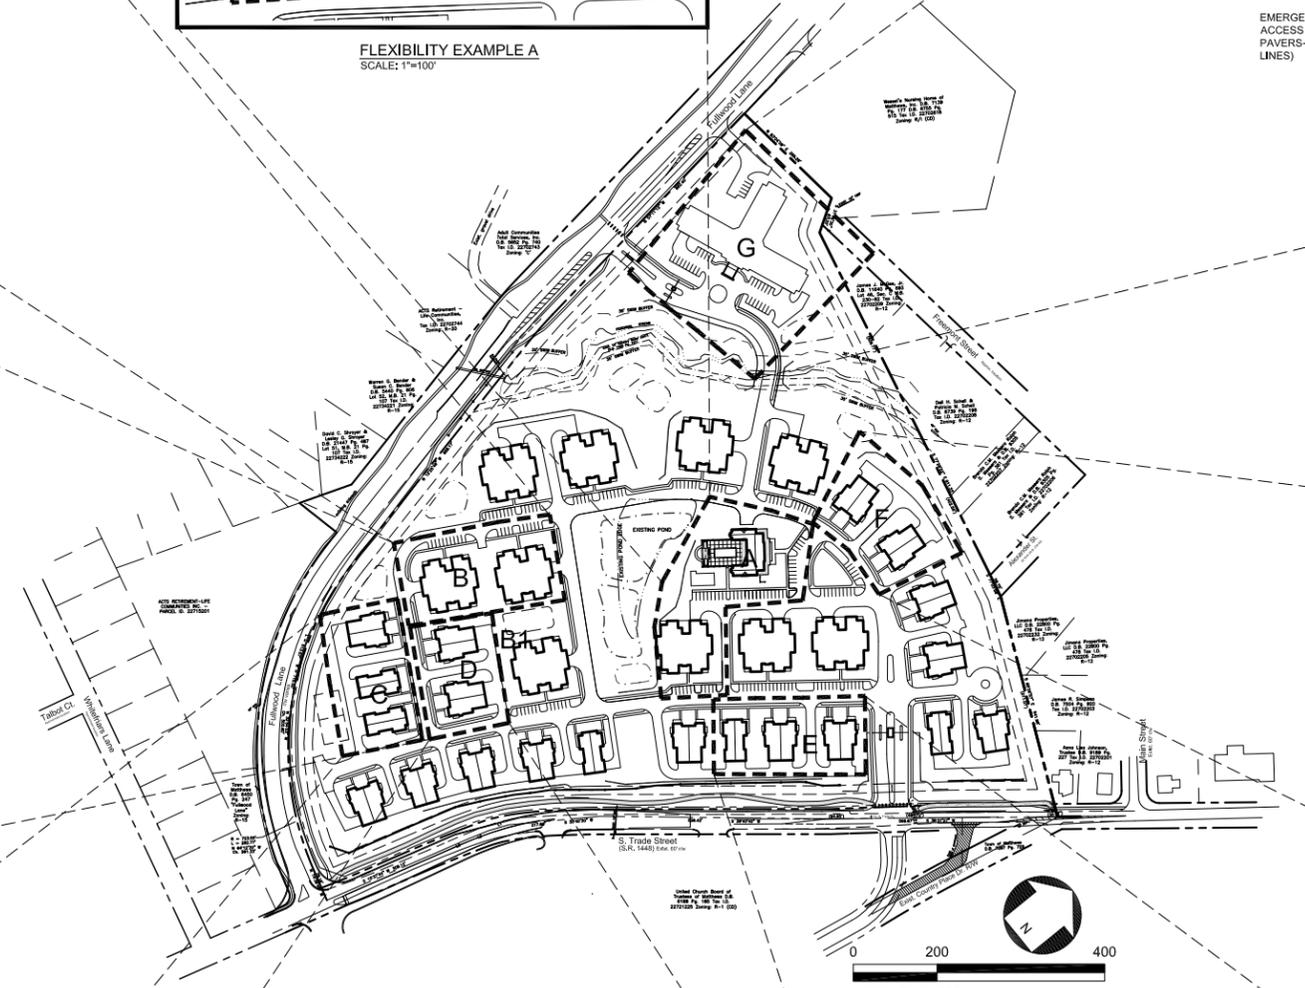

- NOTES:
- MINOR ADJUSTMENTS TO THE SITE PLAN MAY BE MADE, IN CONFORMANCE WITH SECTION 153.201(E) OF THE MATTHEWS ZONING ORDINANCE, AND THE "DEVELOPMENT STANDARDS" INCLUDED IN THIS PETITION.
 - THIS PLAN SHOWS EXAMPLES OF POSSIBLE DEVELOPMENT ALTERNATIVES ALLOWED WITHIN THE DEVELOPMENT STANDARDS. IT DOES NOT REFLECT EVERY POSSIBLE VARIATION ALLOWED BY THE DEVELOPMENT STANDARDS.

No.	Date	By	REVISIONS:
1	8/3/12	SMW	ADDED SHEET

SUPERSEDED 2012-589
8/8/2012



Landworks
Design Group, P.A.
7621 Little Ave., Suite 111
Charlotte, NC 28226
704-841-1604 fax: 704-841-1604



FreemanWhite



**THE VILLAGE AT
PLANTATION ESTATES**
MATTHEWS, NC
REZONING APPLICATION #589

**PHASING
PLAN**

Project Manager: MDL

Drawn By: MDL, TMM


Checked By:

Date: 5/31/12


Project Number: 11015

Sheet Number:

ZP-04

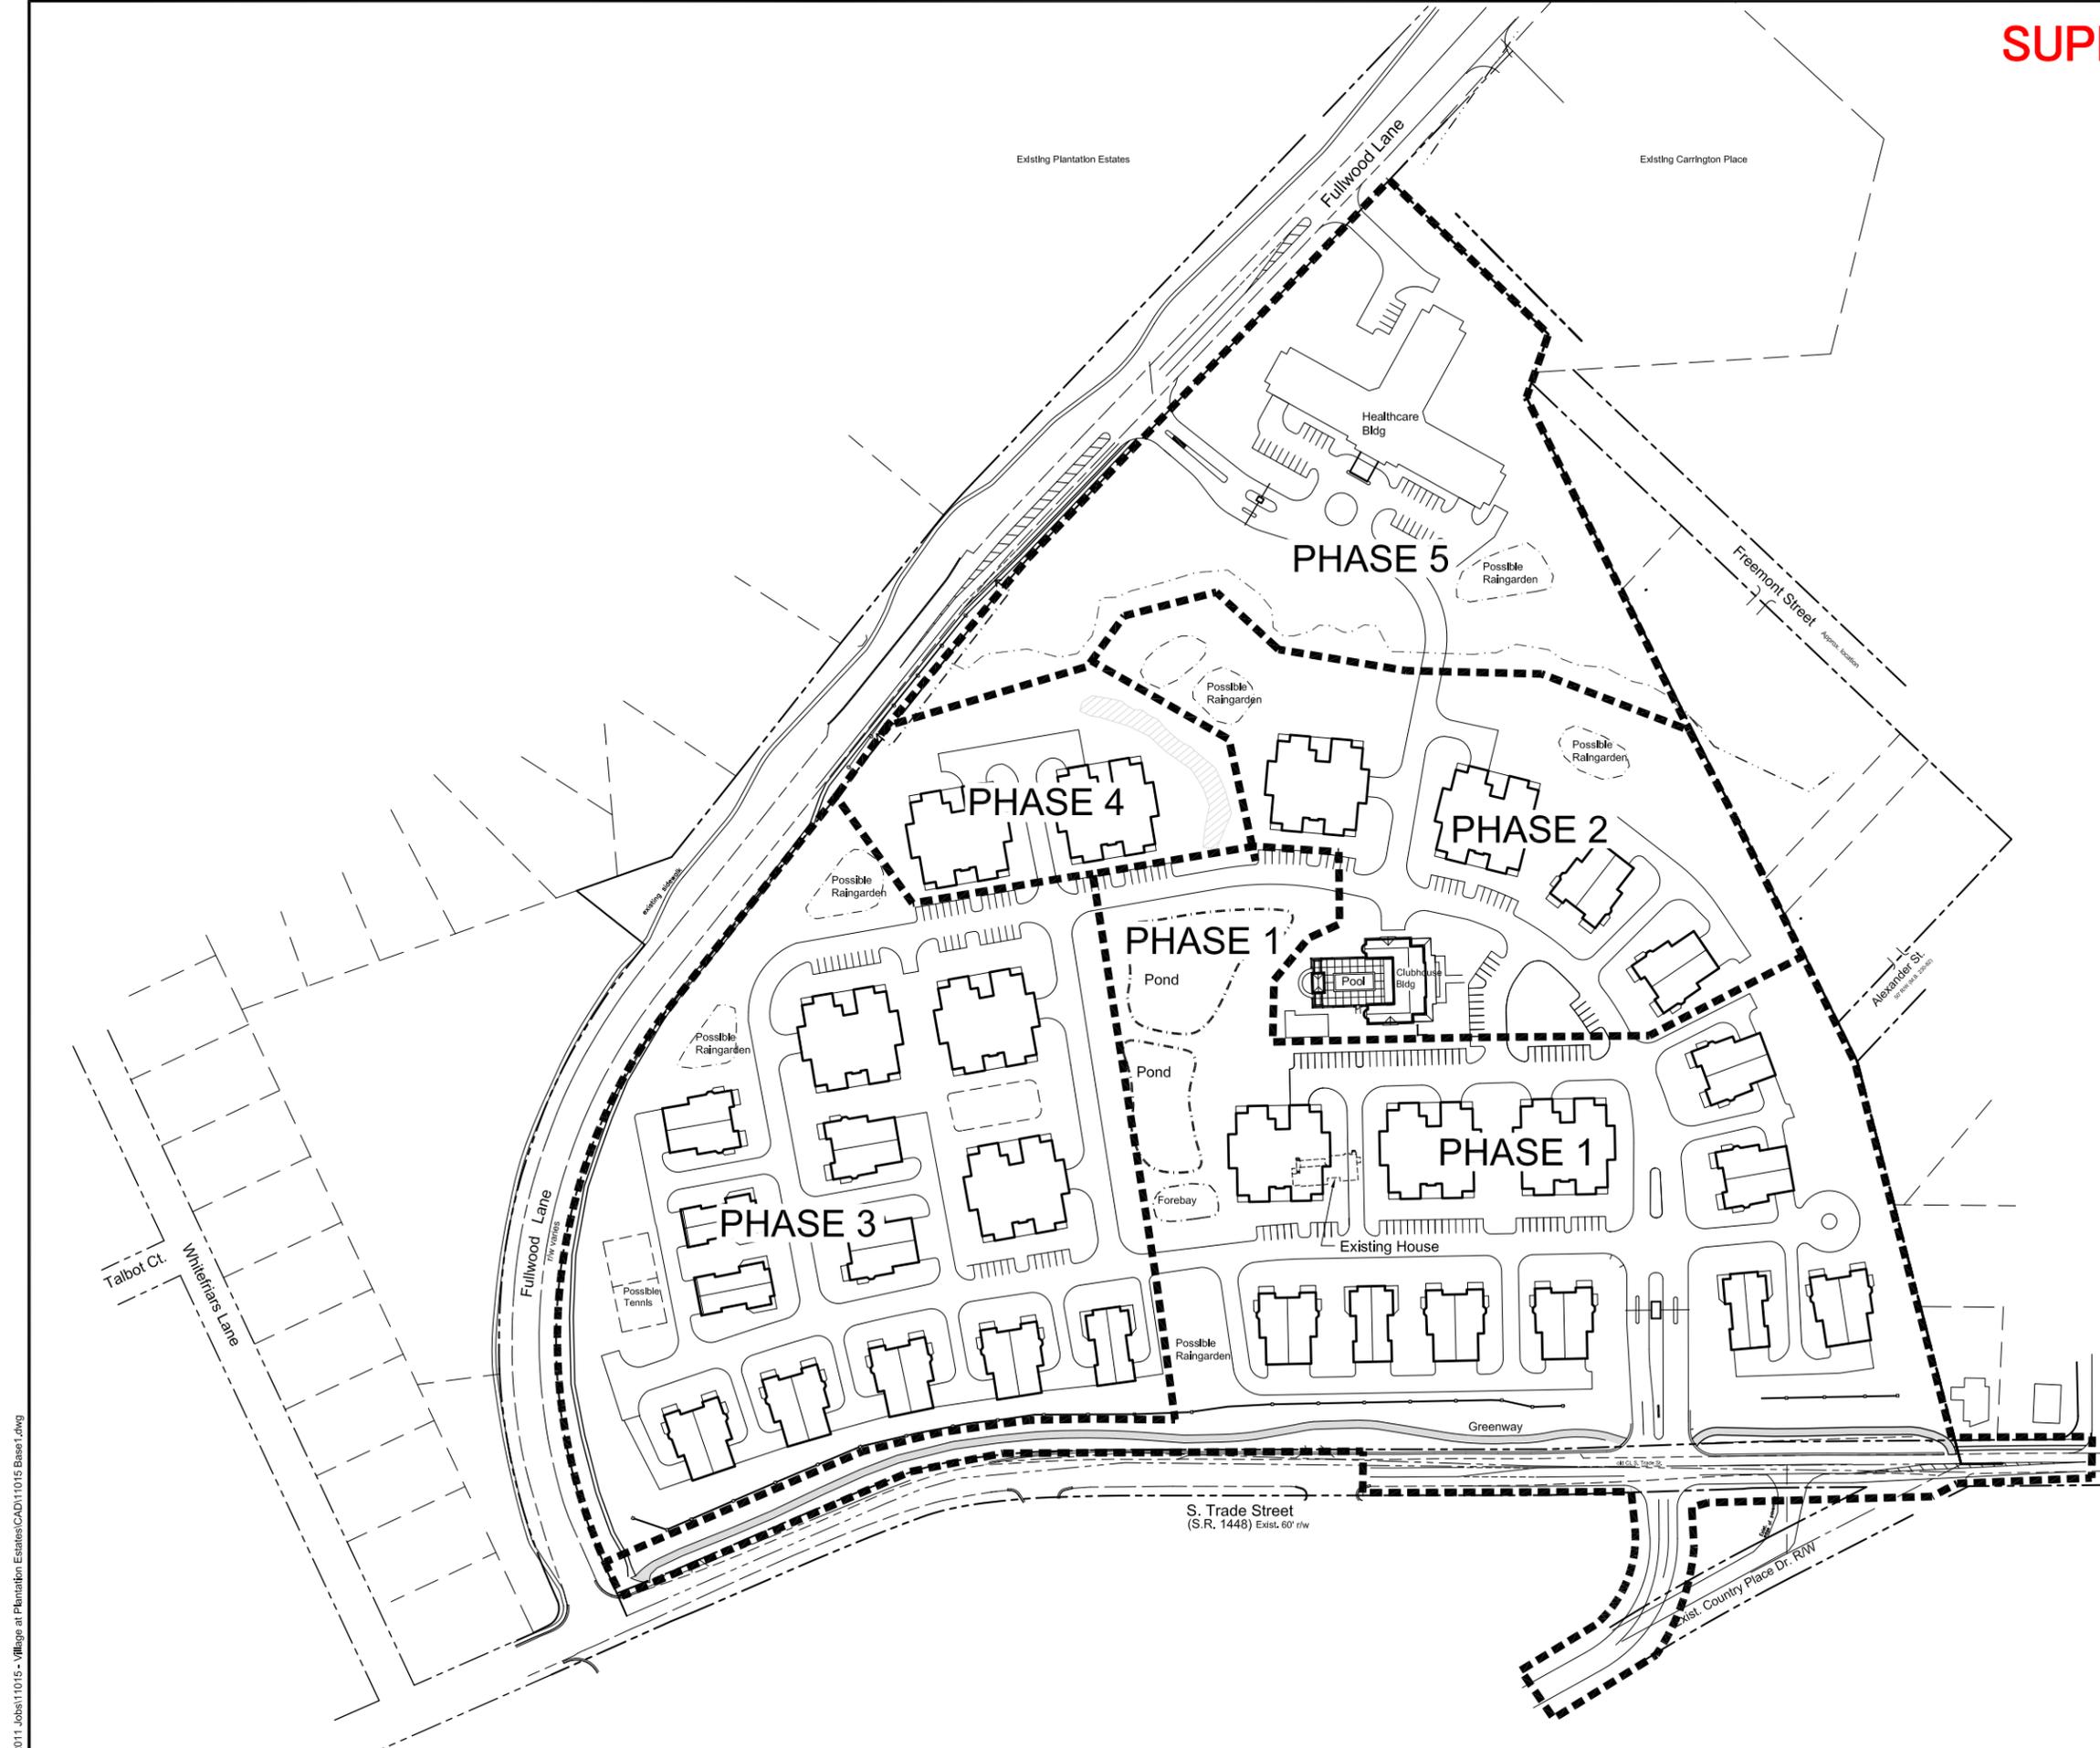

NOTES:
1. THE PHASING SHOWN ON THIS PLAN IS CONCEPTUAL, AND IS SUBJECT TO MODIFICATION BASED ON MARKET CONDITIONS, THE 'DEVELOPMENT STANDARDS', AND OTHER SITE CONDITIONS.

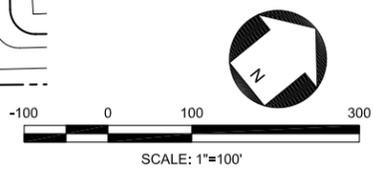

REVISIONS:			
No.	Date	By	Comments
1	8/3/12	SMW	REVISIONS PER TOWN COMMENTS

P:\2011 Jobs\11015 - Village at Plantation Estates\CAD\11015 Base1.dwg

SUPERSEDED 2012-589
8/8/2012

Landworks
Design Group, P.A.
7521 Little Ave., Suite 111
Charlotte, NC 28226
704-841-1604 fax: 704-841-1604

Single Source
DESIGN BUILD

FreemanWhite

ACTS
Retirement-Life
Communities*

**THE VILLAGE AT
PLANTATION ESTATES**
MATTHEWS, NC
REZONING APPLICATION #589

**TREE SAVE
PLAN**

Project Manager: MDL

Drawn By: MDL/TMM

Checked By:

Date: 5/31/12

Project Number: 11015

Sheet Number:

ZP-05



Notes:
1. Tree protection/mitigation zones shown on this plan are conceptual, and are subject to adjustment during the construction document phase, as required to meet zoning ordinance requirements.

LEGEND

	existing deciduous tree
	existing coniferous tree
	tree protection zone
	tree save/mitigation zone



SCALE: 1"=100'

REVISIONS:

No.	Date	By

P:\2011 Jobs\11015 - Village at Plantation Estates\CAD\11015 Base1.dwg

SUPERSEDED 2012-589
8/8/2012

Landworks
Design Group, P.A.
7621 Little Ave., Suite 111
Charlotte, NC 28226
704-841-1604 fax: 704-841-1604

Single Source
DESIGN BUILD

FreemanWhite

ACTS
Retirement-Life
Communities*


**THE VILLAGE AT
PLANTATION ESTATES**
MATTHEWS, NC
REZONING APPLICATION #589

**GREENWAY
TRAIL
DETAILS**



Project Manager: MDL
Drawn By: MDL, TMM
Checked By:
Date: 5/31/12
Project Number: 11015

Sheet Number:

ZP-06

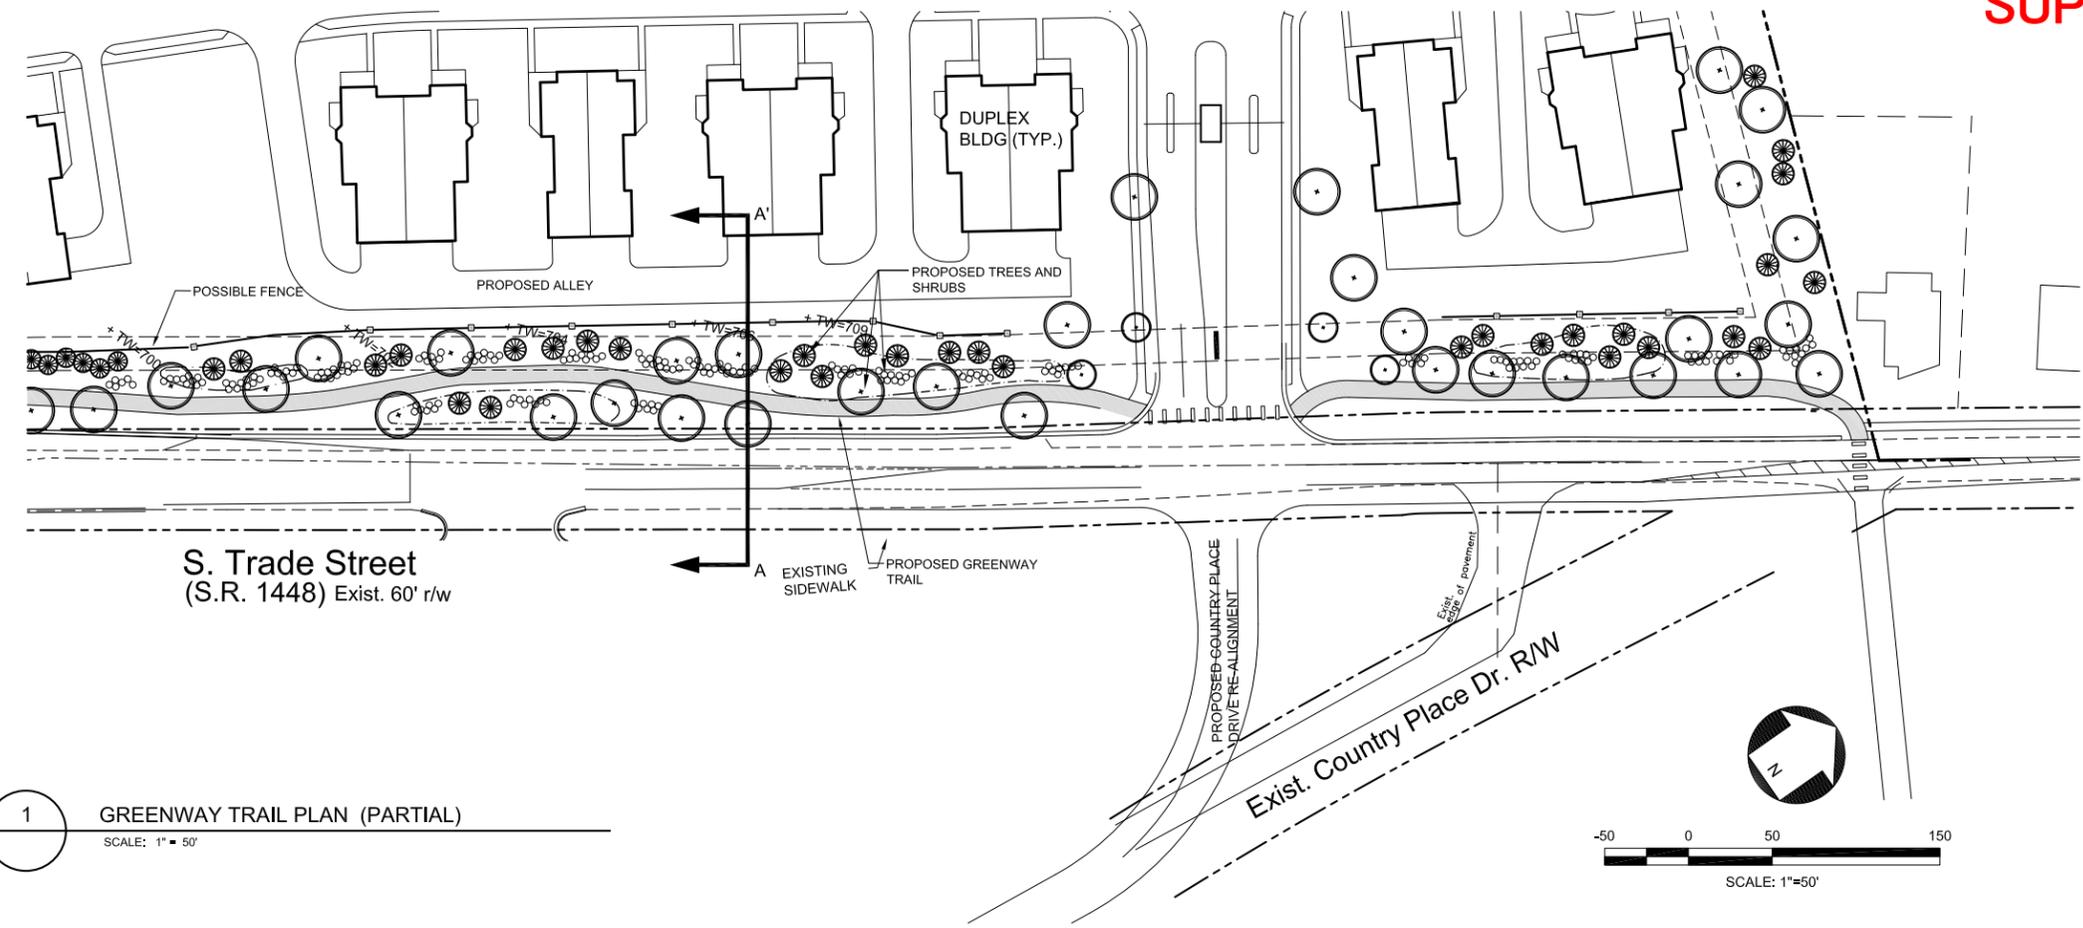

1 GREENWAY TRAIL PLAN (PARTIAL)
SCALE: 1" = 50'

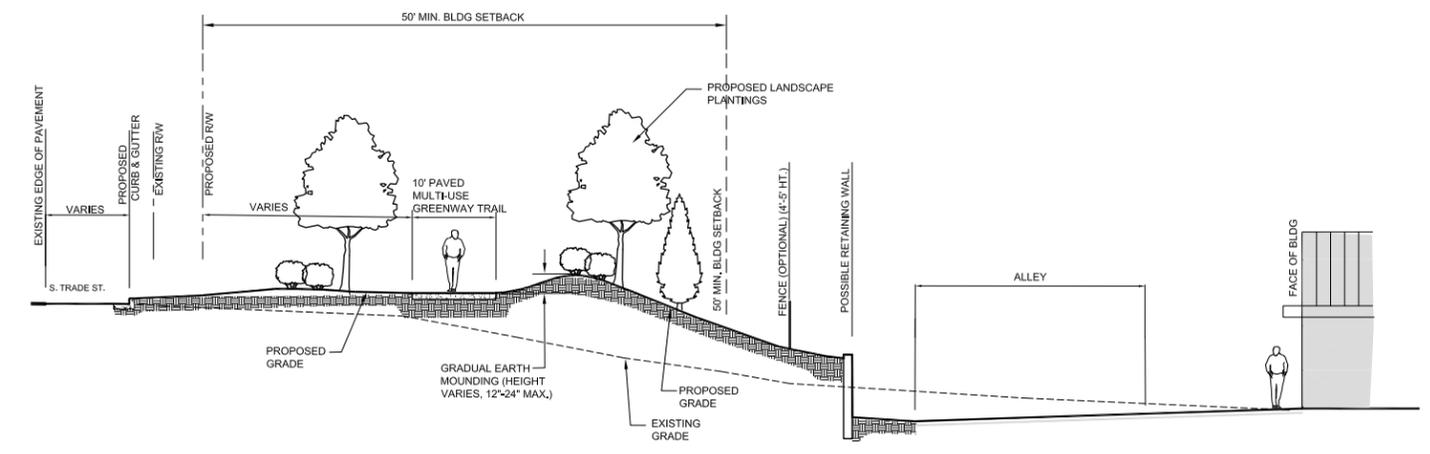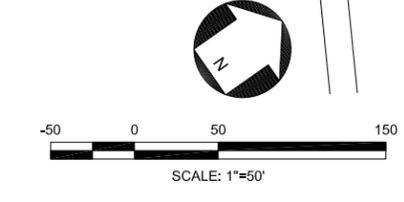

2 SECTION A - A' AT S. TRADE STREET
SCALE: 1/8" = 1'-0"

REVISIONS:

No.	Date	By	Description
1	8/3/12	SMW	MOVED ALL OF GREENWAY TRAIL TO NORTH SIDE OF TRADE ST.

P:\2011 Jobs\11015 - Village at Plantation Estates\CAD\11015 Base.dwg

SUPERSEDED

2012-589
8/8/2012



Landworks
Design Group, P.A.
7621 Little Ave., Suite 111
Charlotte, NC 28226
704-841-1604 fax: 704-841-1604



FreemanWhite




**THE VILLAGE AT
PLANTATION ESTATES**
MATTHEWS, NC
REZONING APPLICATION #589

DETAILS


Project Manager: MDL
Drawn By: AMC
Checked By: TMM
Date: 5/31/12
Project Number: 11015

Sheet Number:


ZP-07

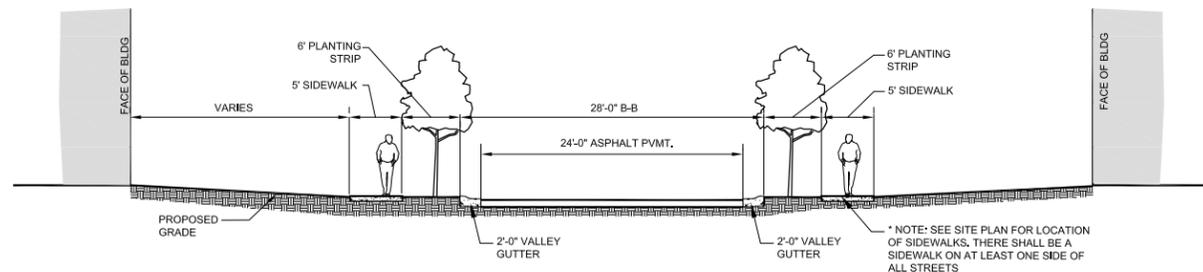


1 TYPICAL INTERNAL STREET TYPE 'A' (PRIVATE)
SCALE: 1/8" = 1'-0"

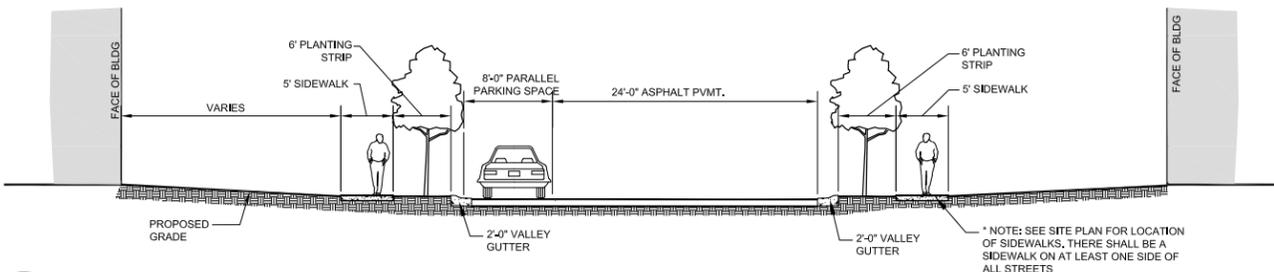

2 TYPICAL INTERNAL STREET TYPE 'A' WITH PARALLEL PARKING
SCALE: 1/8" = 1'-0"

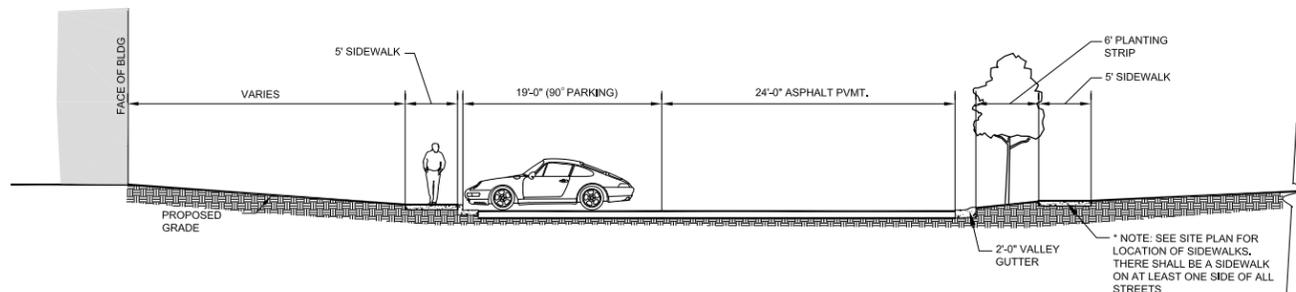

3 TYPICAL INTERNAL STREET TYPE 'A' WITH ANGLED PARKING (PRIVATE)
SCALE: 1/8" = 1'-0"

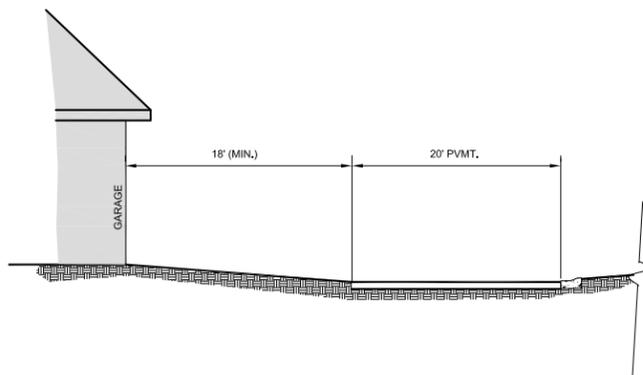

4 TYPICAL ALLEY (SERVING 5 OR MORE DUPLEX UNITS)
SCALE: 1/8" = 1'-0"

REVISIONS:

No.	Date	By

SUPERSEDED 2012-589
8/8/2012



Landworks
Design Group, P.A.
P.O. Box 78060
Charlotte, NC 28271
704-841-1604 fax: 704-841-1604



FreemanWhite



THE VILLAGE AT
PLANTATION ESTATES
MATTHEWS, NC
REZONING PETITION # _____

**BUILDING
ELEVATIONS**

Project Manager: spc

Drawn By: spc

Checked By: spc

Date: 5/31/12

Project Number: 11015

Sheet Number:

ZP-08



1850 DUPLEX (STREET ELEVATION)
SCALE: 1/8" = 1'-0"



1850 DUPLEX (REAR ELEVATION) - SIDE ENTRY GARAGE OPTION
SCALE: 1/8" = 1'-0"



1850 DUPLEX (REAR ELEVATION) - FRONT ENTRY GARAGE OPTION
SCALE: 1/8" = 1'-0"



2050 DUPLEX (STREET ELEVATION)
SCALE: 1/8" = 1'-0"



2050 DUPLEX (REAR ELEVATION) - SIDE ENTRY GARAGE OPTION
SCALE: 1/8" = 1'-0"



2050 DUPLEX (REAR ELEVATION) - FRONT ENTRY GARAGE OPTION
SCALE: 1/8" = 1'-0"



CLUBHOUSE (POND SIDE ELEVATION)
SCALE: 1/8" = 1'-0"



CLUBHOUSE (STREET ELEVATION)
SCALE: 1/8" = 1'-0"

DRAWINGS ARE CONCEPTUAL AND ARE SUBJECT TO CHANGE

REVISIONS:

No.	Date	By

SUPERSEDED 2012-589
8/8/2012



Landworks
Design Group, P.A.
P.O. Box 78060
Charlotte, NC 28271
704-841-1604 fax: 704-841-1604



FreemanWhite



**THE VILLAGE AT
PLANTATION ESTATES**
MATTHEWS, NC
REZONING PETITION # _____

**BUILDING
ELEVATIONS**

Project Manager: spc
Drawn By: spc
Checked By: spc
Date: 5/31/12
Project Number: 11015

Sheet Number:

ZP-09



MAISON COURT APARTMENT BUILDING (REAR ELEVATION)
SCALE: 1/8" = 1'-0"



MAISON COURT APARTMENT BUILDING (STREET ELEVATION)
SCALE: 1/8" = 1'-0"



HEALTHCARE BUILDING (FRONT ELEVATION)
SCALE: 3/32" = 1'-0"

No.	Date	By

DRAWINGS ARE CONCEPTUAL AND ARE SUBJECT TO CHANGE



Landworks
Design Group, P.A.
P.O. Box 78060
Charlotte, NC 28271
704-841-1604 fax: 704-841-1604



FreemanWhite



THE VILLAGE AT
PLANTATION ESTATES
MATTHEWS, NC
REZONING PETITION # 589

DECORATIVE
WALL AND
SIGN
DETAILS

Project Manager: spc

Drawn By: spc

Checked By: spc

Date: 8/3/12


Project Number: 11015

Sheet Number:

ZP-11

REVISIONS:

No.	Date	By
#1	8/3/12	SHEET ADDED

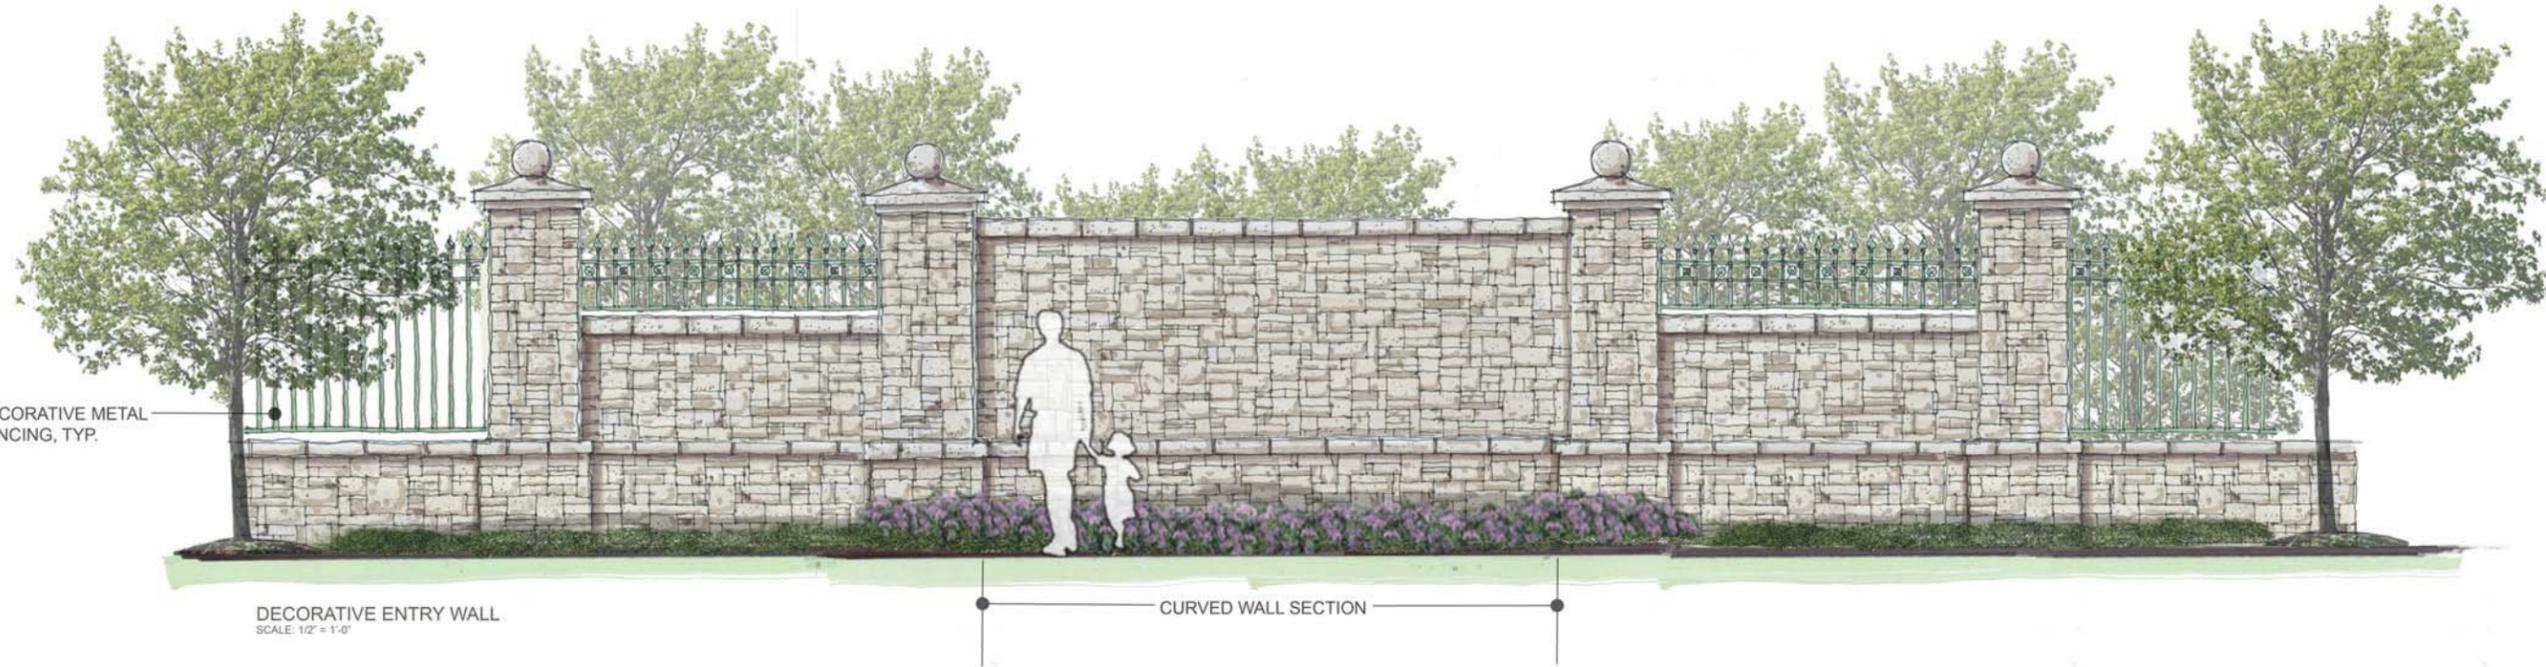

DRAWINGS ARE CONCEPTUAL AND ARE SUBJECT TO CHANGE

SUPERSEDED


2012-589
6/1/2012

Development Standards:

- The development of the site will be controlled by the standards depicted on this site plan and by the Matthews Zoning Code to accommodate a Continuing Care Retirement Community in this R-1 (CD). The development will have independent living units, healthcare beds and their related accessory uses. No other uses that might be allowed in the R-1 district are proposed to be located on the project site. The density on the site will not exceed 10 dwelling units per acre. The site will include a variety of dwelling styles and sizes and may include small service uses as allowed by the provisions of Section 153.195 (A) (6) for the sole use and convenience of the residents, their guests, vendors and the staff.
- The development depicted on this site plan is intended to reflect the arrangement of proposed uses on the site, but the exact configuration, placement, and size of individual site elements may be altered or modified within the limits prescribed herein and by the Matthews Zoning Code during the design development and construction phases. Minor adjustments and amendments to the site plan may be considered so long as the Matthews Zoning Code, the overall concept for the site, and the conditions of the site plan are preserved. Additional changes and modifications of the site plan may be proposed that are in conformance with the provisions of Section 153.201(E) of the Matthews Zoning Code.
- At no time will the total number of independent living units on the site exceed 300. The petitioner reserves the right to modify the number of each individual unit type based on market conditions. Additionally, at no time will the total number of assisted living beds and/or skilled nursing beds exceed 140. The site may also include a resident clubhouse with offices, wellness center, and bistro. It may also contain a maintenance building, gatehouse and other site amenities. For each building type listed below, the established limits will not be exceeded.
- The maximum square footage of each single family home (simplex) will not exceed 3,000 square feet, exclusive of the garage; two-family home (duplex) will not exceed 6,000 square feet, exclusive of the garage; and three-family home (triplex) will not exceed 9,000 square feet, exclusive of the garage. The maximum combined square footage of these homes will not exceed 300,000 square feet. These homes will have up to four bedrooms and will have a one or two car garage. The maximum number of each home type is 70 simplex buildings or 70 living units, 50 duplex buildings or 100 living units, and 30 triplex buildings or 90 living units. These homes will be up to one and a half stories high and will not exceed 35 feet, as measured per the Matthews Zoning Code.
- The maximum square footage of each apartment building will not exceed 60,000 square feet, exclusive of the garage. The maximum combined square footage of these apartment buildings will not exceed 825,000 square feet. These apartments will have up to three bedrooms on up to three levels of residential floors and may include under-building/ground garages. These apartment buildings will be up to four stories in height and include up to 24 living units per building. These apartment buildings will not exceed 270 total living units. The maximum height of the apartment buildings will not exceed 60 feet, as measured per the Matthews Zoning Code.
- The maximum square footage of the resident clubhouse building will not exceed 30,000 square feet. This building may include administration offices, meeting facilities, kitchen and dining facilities, swimming pools, exercise spaces, maintenance shops, apartments and other ancillary services. This building will be up to four stories in height and may include under-building/ground garages. The maximum height of this building will not exceed 60 feet, as measured per the Matthews Zoning Code.
- The maximum square footage of the skilled nursing/assisted living buildings will not exceed 150,000 square feet exclusive of the garage, and will not exceed 140 beds. These buildings will be up to four stories in height. The maximum height of the skilled nursing/assisted living buildings will not exceed 60 feet, as measured per the Matthews Zoning Code.
- The Petitioner has provided building elevations for the structures to be constructed on the site. The building illustrations that are included with this petition are intended to reflect the general mass, scale, configuration, and the architectural character of the buildings. The Petitioner may make revisions to the design and materials of the buildings so long as the general mass, scale, configuration, and architectural character of the buildings are maintained in accordance with the Matthews Zoning Code.
- Brick or stone will be used on a minimum of 50% of each building elevation that fronts upon either an exterior public street or internal private street. Each elevation may also incorporate additional masonry materials such as decorative block. A minimum of 30% of each elevation that fronts upon either an exterior public street or internal private street may be clad in cement-plank siding. A maximum of 15% of each elevation that fronts upon either an exterior public street or internal private street may be of exterior insulation finish system or stucco. Should the percentage of brick or stone exceed 50%, the minimum percentage required for cement-plank siding will not apply. These requirements do not apply to enclosed walkways, windows, doors, soffits, gable ends and/or other architectural treatments, nor shall they apply to detached garages. Detached garages, however, will be constructed in a manner and with materials that will complement the associated home or apartment building. Additional materials used on the site include, but are not limited to asphalt or fiberglass shingles or metal on mansard and pitched roofs, and membrane roof systems on flat roofs.
- This development will be constructed in phases subject to modifications based on market conditions and other site conditions. Transportation improvements contained herein will be incorporated into the site phase development process as the various portions of the site are developed. To coordinate with construction of proposed roadway improvement projects planned by the Town of Matthews, the Petitioner reserves the right to provide payment in lieu of the construction of curb and gutter along portions of South Trade Street and Fullwood Lane.
- The Petitioner shall work with Matthews United Methodist Church and the Town of Matthews to relocate Country Place Drive through the Church's property to align with the main entrance into the site. The Petitioner will bear all reasonable cost of the construction of these improvements as well as the reasonable cost of a traffic signal either when warranted or approved by the appropriate governing body having jurisdiction over the road. These improvements will be installed as a part of Phase I, except the signal installation may come at a later date as approval is obtained.



- Upon approval of this rezoning petition, the Petitioner intends to unilaterally donate or provide to the Town of Matthews a 100 year lease at \$1.00 per year for Tax Parcel # 22715201 (located west of Fullwood Lane), for exclusive use by the Town of Matthews for municipal purposes.
- Parking will be provided in accordance with the Matthews Zoning Code Section 153.117 Schedule of Off-Street Parking. Parking will be provided in garages associated with each simplex/duplex/triplex home. Parking will be provided in garages, surface lots and on-street parking areas for each apartment building. The Petitioner reserves the right to also provide on-street pull-in and parallel parking spaces on the internal private streets in addition to the parking spaces shown on the site plan. The Parking Plan required by Section 153.123 of the Matthews Zoning Code will be submitted as a separate document from this Rezoning Petition with each site phase.
- Signage will be permitted in accordance with the Matthews Zoning Code Section 153.150. Detached signage will be limited to ground mounted monument signs that will identify the development at each public street vehicular access road limited to 40 square feet in area for each sign. It is the intent of the petitioner to locate signage at/near the main entrance on South Trade Street and at/near the entrance at Fullwood Lane as permitted by the Schedule of Sign Regulations. The materials of these signs will be compatible with the materials used to construct the buildings on the site. The Internal directional signage may also be utilized on either a temporary or permanent basis. The Master Sign Plan required by Section 153.149 of the Matthews Zoning Code will be submitted as a separate document from this Rezoning Petition.
- Fire Department site access will be provided by a driveway connection at South Trade Street and a driveway connection at Fullwood Lane. Temporary emergency access may be provided from Fullwood Lane due to the phasing of the site development. The Petitioner reserves the right to provide vehicle and pedestrian gates at both of these access points. All gates will be accessible by emergency services per the Town of Matthews Ordinance. There will not be an internal street connection with Freemont Street.
- The site will be designed and constructed to comply with the Town of Matthews Fire Department Standards. Fire Hydrants will be provided within 750 feet of the most remote point of every building as the truck travels. All stream crossings and emergency service roads or pathways will be built to withstand loads of 80,000 pounds and an 8 foot wheel base.
- The apartment buildings and garages will be equipped with fire alarm systems and automatic sprinkler systems as required by the NC State Building Code.
- The Petitioner will install an 8 foot wide greenway trail on the edge of the property along South Trade Street and a 5 foot sidewalk on the edge of the property along Fullwood Lane, as generally indicated on the Site Plan. The exact path of the greenway trail will be determined during the development review and approval process. The Petitioner will provide a greenway access and use easement on its property for any portion of the greenway trail indicated on the site plan that is outside of the public street right-of-way. The Petitioner reserves the right to provide payment in lieu of the construction of the greenway trail due to the future construction of the proposed roadway projects along South Trade Street and Fullwood Lane. The Petitioner will install an internal sidewalk system that will connect the units on the site with the greenway and sidewalks on the adjacent public streets.
- The Petitioner will dedicate up to an additional 15 feet of right-of-way along Fullwood Lane and South Trade Street, measured from existing street right-of-way lines, within 400 feet of the intersection of Fullwood Lane and South Trade Street, as required to accommodate future Town of Matthews road projects in the vicinity of the site. The Petitioner reserves the right to provide payment in lieu of the construction of the curb and gutter and sidewalks due to the future construction of the proposed roadway projects along South Trade Street and Fullwood Lane.
- The Petitioner will install 30 foot wide streetscape landscape areas along Fullwood Lane and South Trade Streets, as generally indicated on the site plan and measured from the street right of ways. No buildings or parking will be placed within these landscape areas. Existing trees and shrubs preserved within these areas may be used to meet the landscape requirements of the Ordinance. Additionally, new trees and shrubs may be added to these landscape areas as required to meet Zoning Ordinance requirements. Landscaped berms, sidewalks, and/or greenway trails may be installed within these landscape areas. The Petitioner reserves the right to selectively clear underbrush, invasive weeds, and poison ivy within the 30 foot landscaped areas in accordance with the Ordinance.
- The Petitioner will install 30 foot wide perimeter landscape areas along the project perimeter adjacent to existing residential development, as generally indicated on the site plan. No buildings, parking, or detention ponds will be placed within these landscape areas. Existing trees and shrubs will be preserved within these perimeter areas whenever practical. Additionally, new trees and shrubs may be added to these landscape areas to meet Town of Matthews Zoning Ordinance requirements. The Petitioner reserves the right to selectively clear underbrush, invasive weeds, and poison ivy within the 30 foot landscape areas in accordance with the Ordinance.
- The Petitioner may install fencing and/or screen walls along the perimeter of the site, provided that fencing or screen walls shall be no closer than 15 feet to any exterior property line. Entry signage and associated decorative walls may be closer to street right of ways, subject to Ordinance requirements. Finish materials of the fences or walls may include brick, stone, EIFS or comparable, decorative metal, aluminum, manufactured wood and wood. The finished side of fencing/screen walls shall face outward from the property.
- Approximate tree save areas are shown on the Tree Protection Plan. The Petitioner may supplement the existing trees per Ordinance guidelines. The Petitioner also reserves the right to provide tree planting mitigation (replanting) in accordance with the Town of Matthews Ordinance guidelines.
- The minimum unobstructed open space for the site is 50% in conformance with Section 153.195 of the Matthews Zoning Code at Table 1 for Continuing Care Retirement Communities.

- All outdoor lighting shall comply with the Matthews Zoning Code. No open lens lighting will be installed, but architectural lighting on building facades and landscape areas will be permitted.
- The Petitioner reserves the right to demolish the existing brick wall along South Trade Street to install road improvements, greenway trails/sidewalks, and/or landscape improvements. The existing concrete monument will be donated to the Town of Matthews for reuse at an off-site location.
- There is an existing pond on the site. The Petitioner may, during the construction of the site, drain, clean and redesign this pond to better accommodate storm water and develop a more attractive open space and open space amenity. As a result, the final location and dimensions of the pond may be modified during construction.
- Project wide water quality features, including storm water detention facilities, will be designed to meet the applicable standards of the Town of Matthews, including the Phase 2 controls (post- construction) standards.
- SWIM buffers will be provided in accordance with the Mecklenburg County Ordinance requirements.
- Throughout this Rezoning Petition, the terms "Owner", "Owners", "Petitioner" or "Petitioners", shall, with respect to the Site, be deemed to include the heirs, devisees, agents, personal representatives, successors in interested and assignees of the owner or owners of the Site who may be involved in its development from time to time.

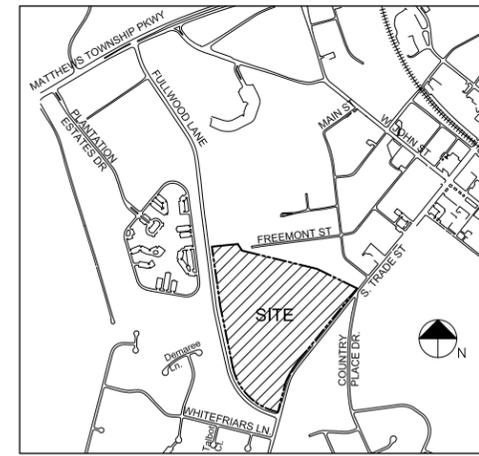

2012-589
6/1/2012


REVISED 08-15-08: Added interior calls and areas, revise wetlands note and zoning designation. No field work was done at this time.
REVISED 09-16-08: Removed Temporary Construction Easement (DB 6450-247) based on revised title commitment / address attorney comments. No field work was done at this time.

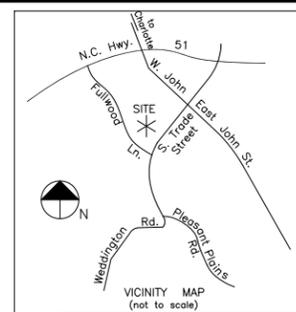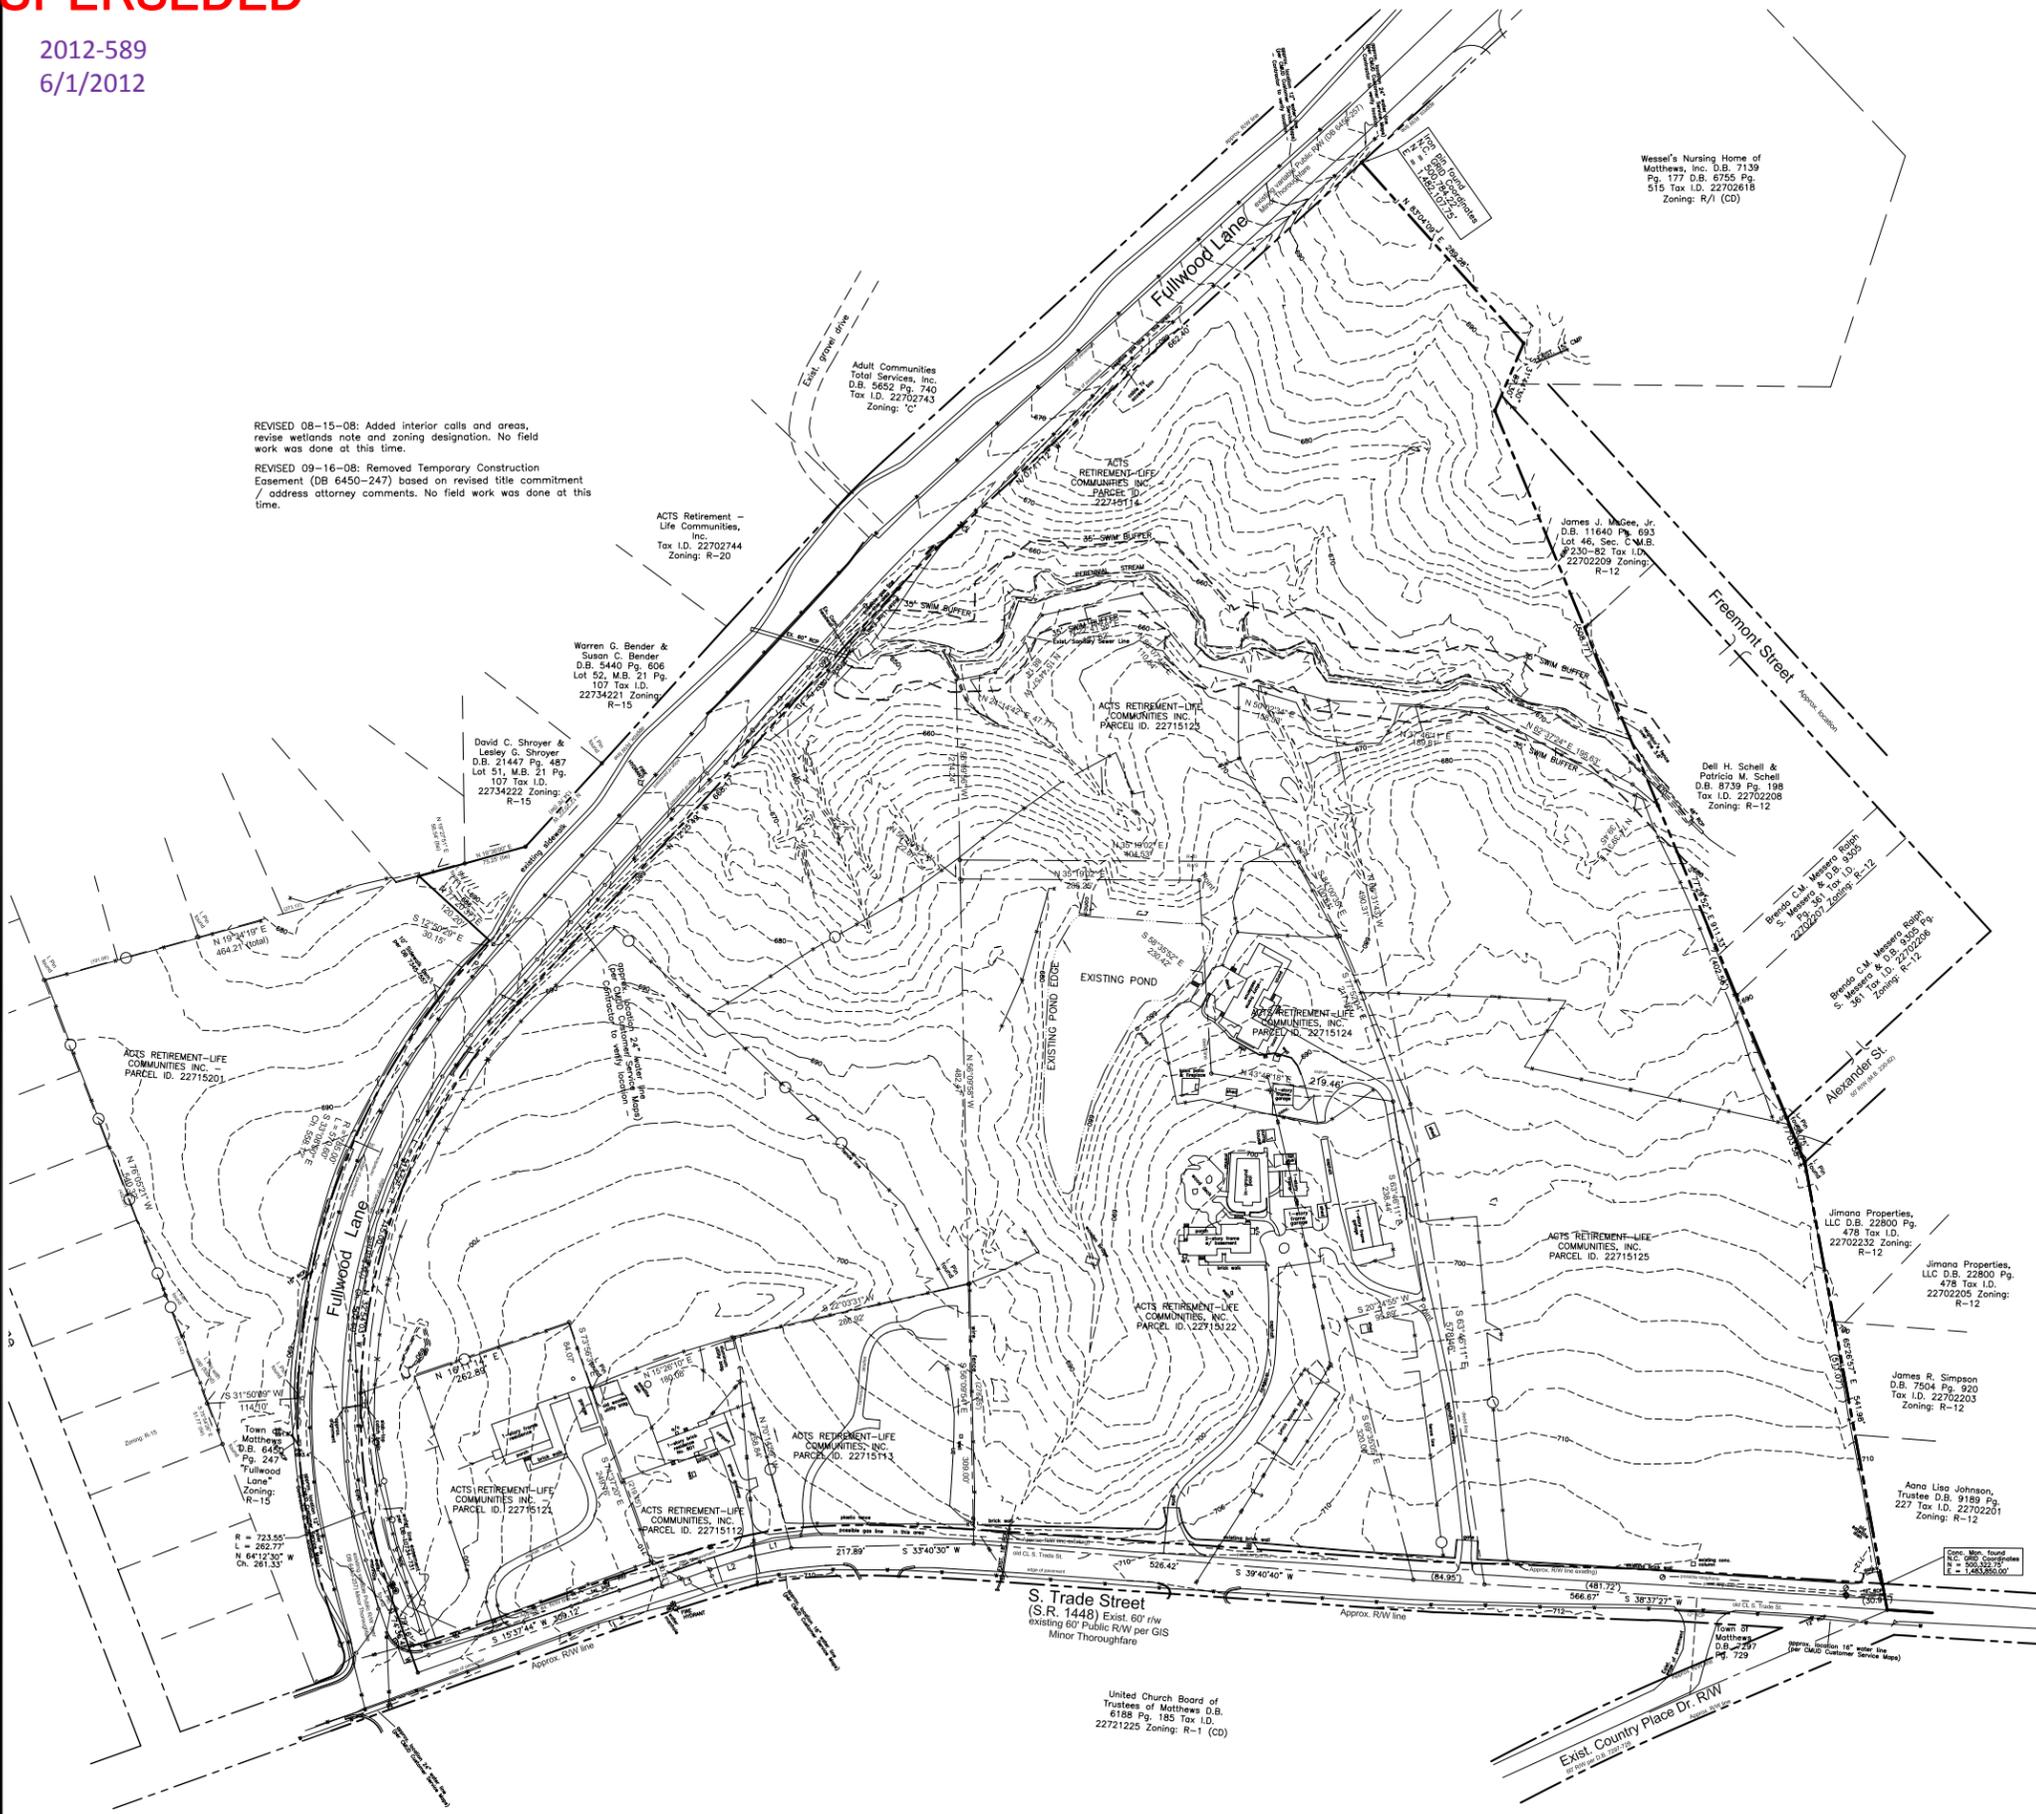

LEGEND

ch.	chord
LR	curve length & radius
s.f.	square feet (by coordinates)
IPS	iron pin set
conc.	concrete
a/c	air conditioner
MB, DB	record map and deed references
+	light pole
o	utility pole
o	gas valve
o	guy anchor
o	catch basin
o	water meter
o	water valve
o	fire hydrant
o	sanitary sewer manhole
o	sanitary sewer clean-out
o	deciduous tree
o	coniferous tree
o	telephone manhole
o	electric manhole
o	underground gas line
o	sanitary sewer manhole
T.B.M.	temporary bench mark
-T-	underground telephone line
-W-	water line
-SS-	sanitary sewer line
-UE-	underground electric
-OE-	overhead electric
-X-	fence line
RCP	reinforced concrete pipe
CMP	corrugated metal pipe
I.E.	invert elevation
X	spot elevation

EXISTING CONDITIONS ARE FROM A SURVEY BY A.G. ZOUTEWELLE, P.A. DATED 04-08-08. LATEST REVISION 09-15-08.

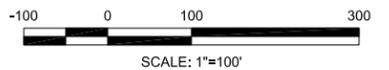

REVISIONS:

No.	Date	By

Landworks
Design Group, P.A.
P.O. Box 78060
Charlotte, NC 28271
704-841-1604 fax: 704-841-1604

Single Source
DESIGN BUILD

FreemanWhite

ACTS
Retirement-Life
Communities*

THE VILLAGE AT
PLANTATION ESTATES
MATTHEWS, NC
REZONING PETITION # _____

EXISTING
CONDITIONS
PLAN

Project Manager: MDL

Drawn By: MDL, TMM

Checked By:

Date: 5/31/12

Project Number: 11015

Sheet Number:

ZP-01

SUPERSEDED

2012-589
6/1/2012



Landworks
Design Group, P.A.
P.O. Box 78060
Charlotte, NC 28271
704-841-1604 fax: 704-841-1604

Single Source
DESIGN BUILD

FreemanWhite

ACTS
Retirement-Life Communities®

**THE VILLAGE AT
PLANTATION ESTATES**
MATTHEWS, NC
REZONING PETITION # _____

**GRAPHIC
SITE PLAN**

Project Manager: MDL

Drawn By: MDL, TMM

Checked By:

Date: 05/31/12

Project Number: 11015

Sheet Number:

REVISIONS:		
No.	Date	By

ZP-02

P:\2011 Jobs\11015 - Village at Plantation Estates\CAD\11015 Base.dwg

SUPERSEDED

2012-589
6/1/2012



Landworks
Design Group, P.A.
P.O. Box 78060
Charlotte, NC 28271
704-841-1604 fax: 704-841-1604



FreemanWhite



**THE VILLAGE AT
PLANTATION ESTATES**
MATTHEWS, NC
REZONING PETITION # _____

**SITE
LAYOUT
PLAN**

Project Manager: MDL

Drawn By: MDL, TMM


Checked By:

Date: 05/31/12


Project Number: 11015

Sheet Number:

ZP-03

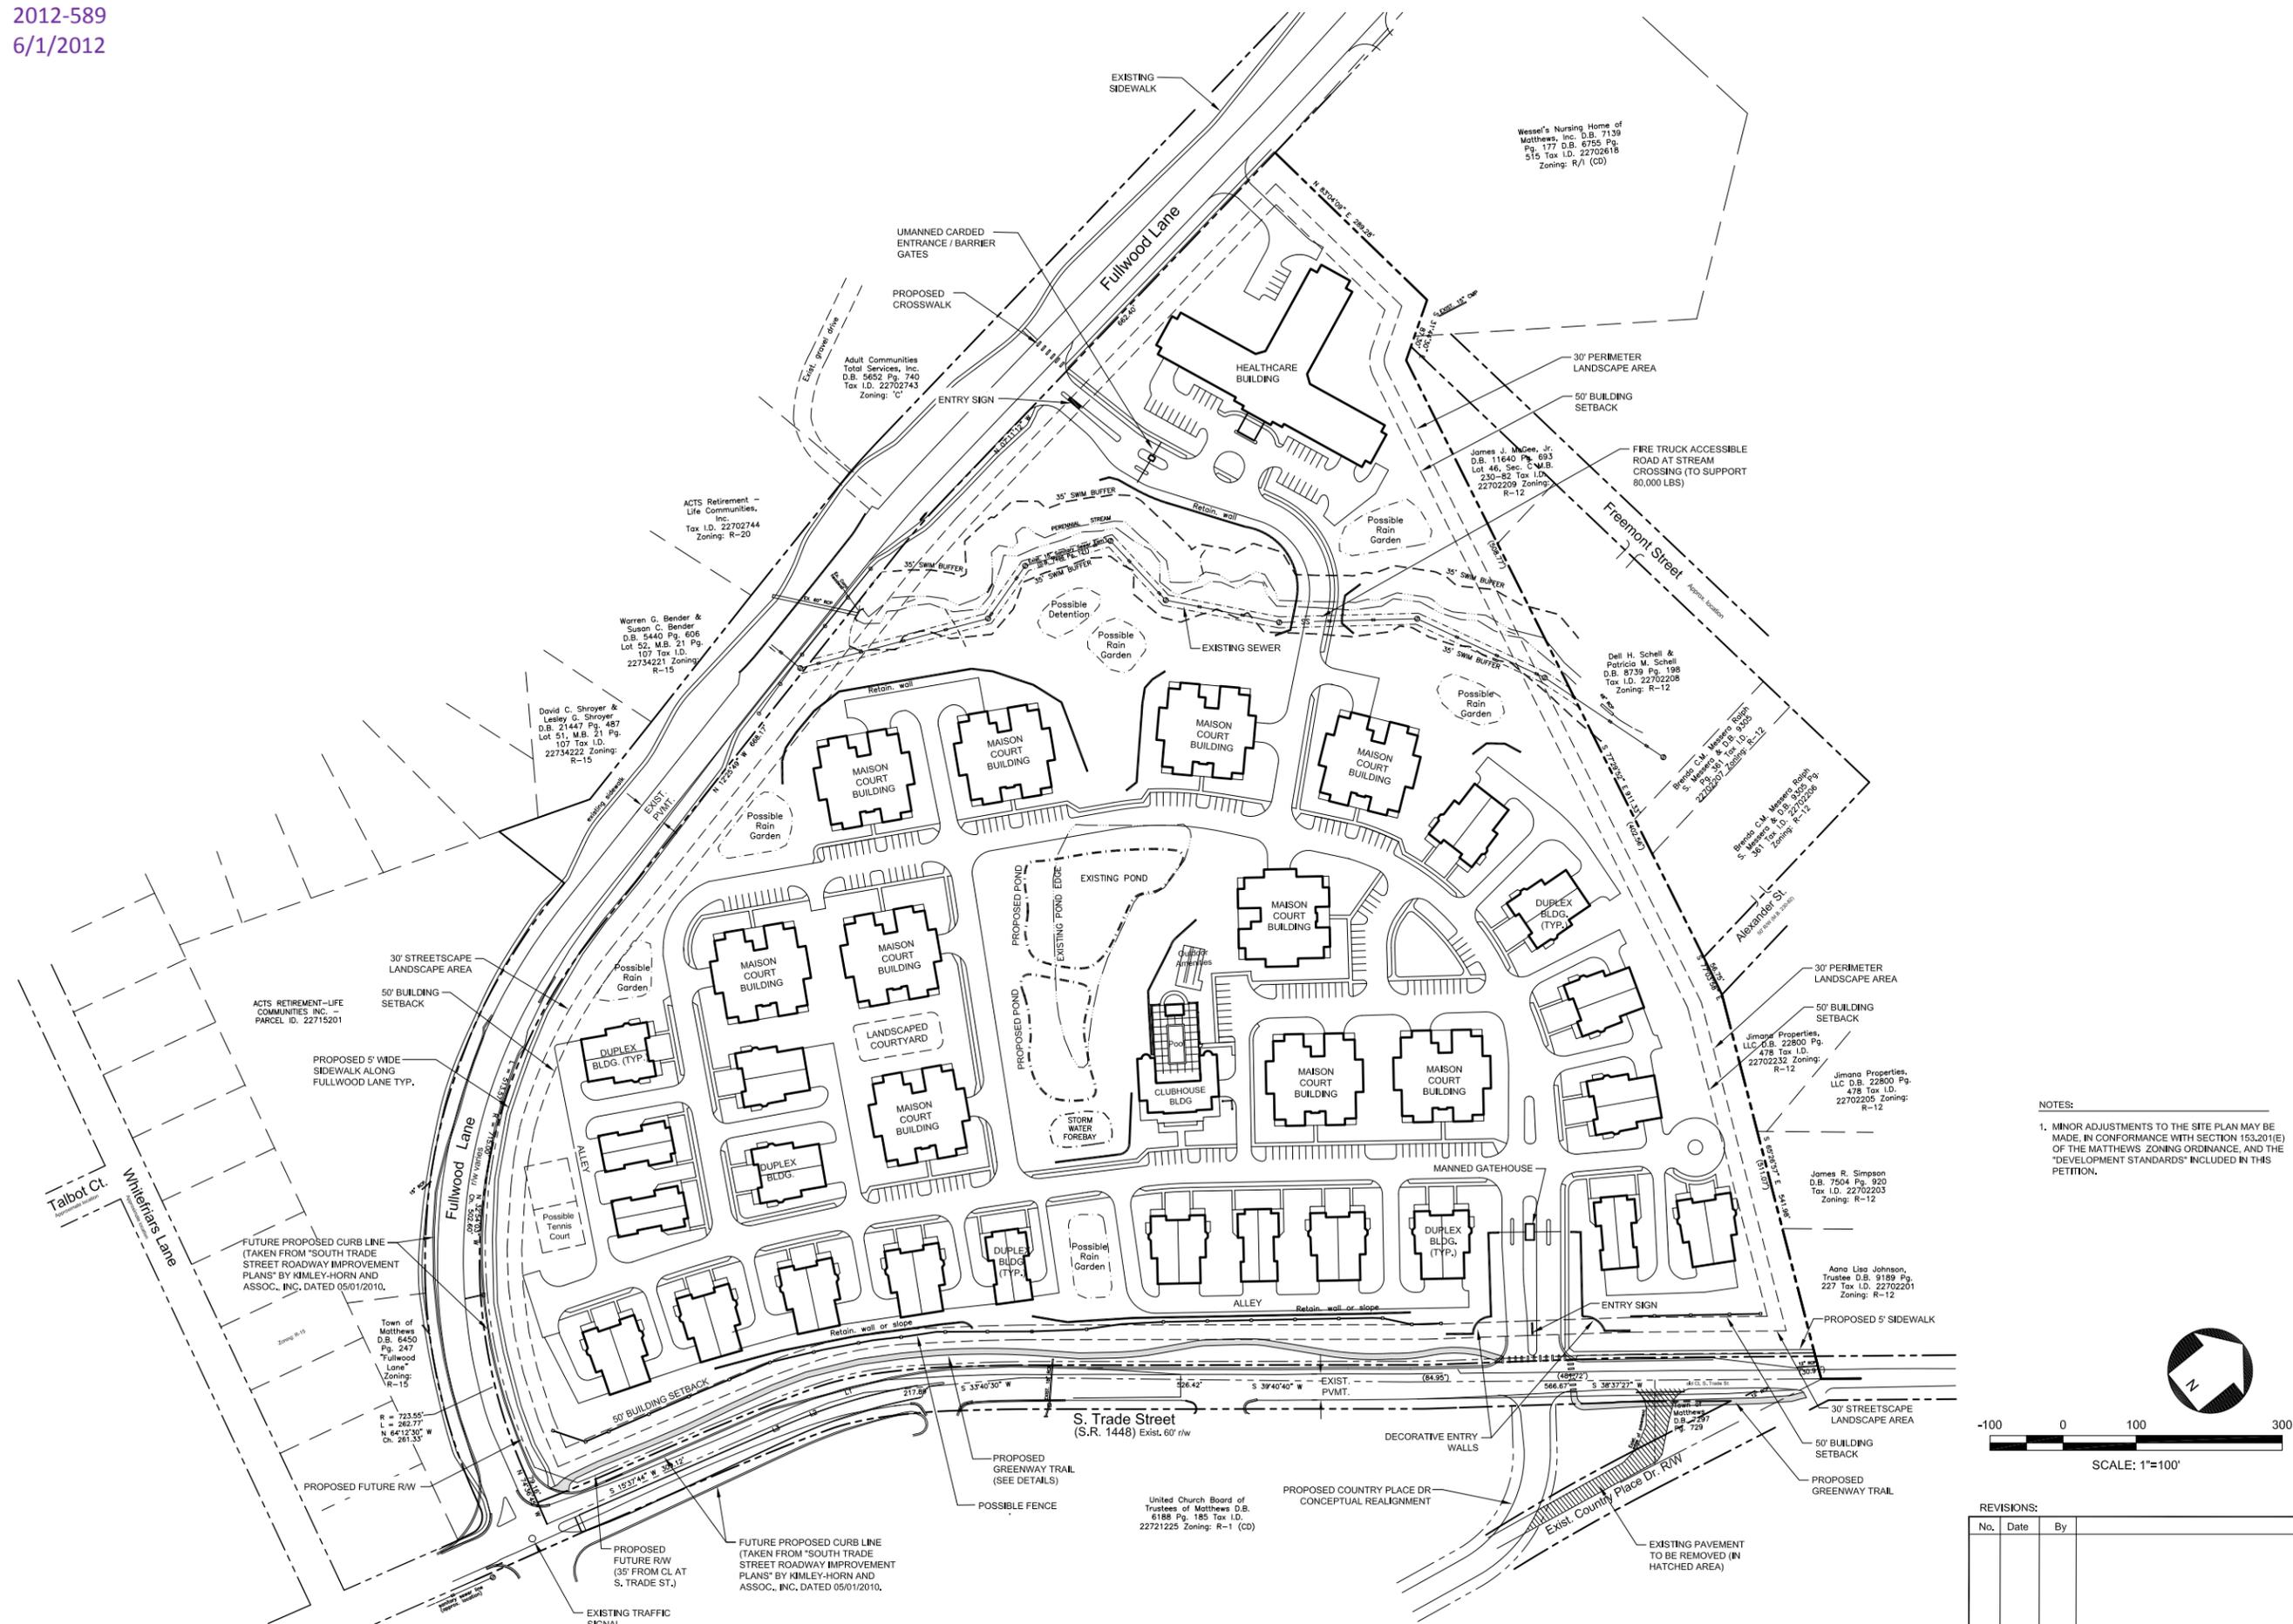

NOTES:
1. MINOR ADJUSTMENTS TO THE SITE PLAN MAY BE MADE, IN CONFORMANCE WITH SECTION 153.201(E) OF THE MATTHEWS ZONING ORDINANCE AND THE "DEVELOPMENT STANDARDS" INCLUDED IN THIS PETITION.

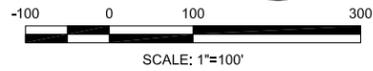

REVISIONS:		
No.	Date	By

PC2011 Jobs11015 - Village at Plantation Estates CAD11015 Base.dwg

SUPERSEDED

2012-589
6/1/2012



Landworks
Design Group, P.A.
P.O. Box 78060
Charlotte, NC 28271
704-841-1604 fax: 704-841-1604



FreemanWhite



**THE VILLAGE AT
PLANTATION ESTATES**
MATTHEWS, NC
REZONING PETITION # _____

**PHASING
PLAN**

Project Manager: MDL

Drawn By: MDL, TMM


Checked By:

Date: 5/31/12

Project Number: 11015


Sheet Number:

ZP-04

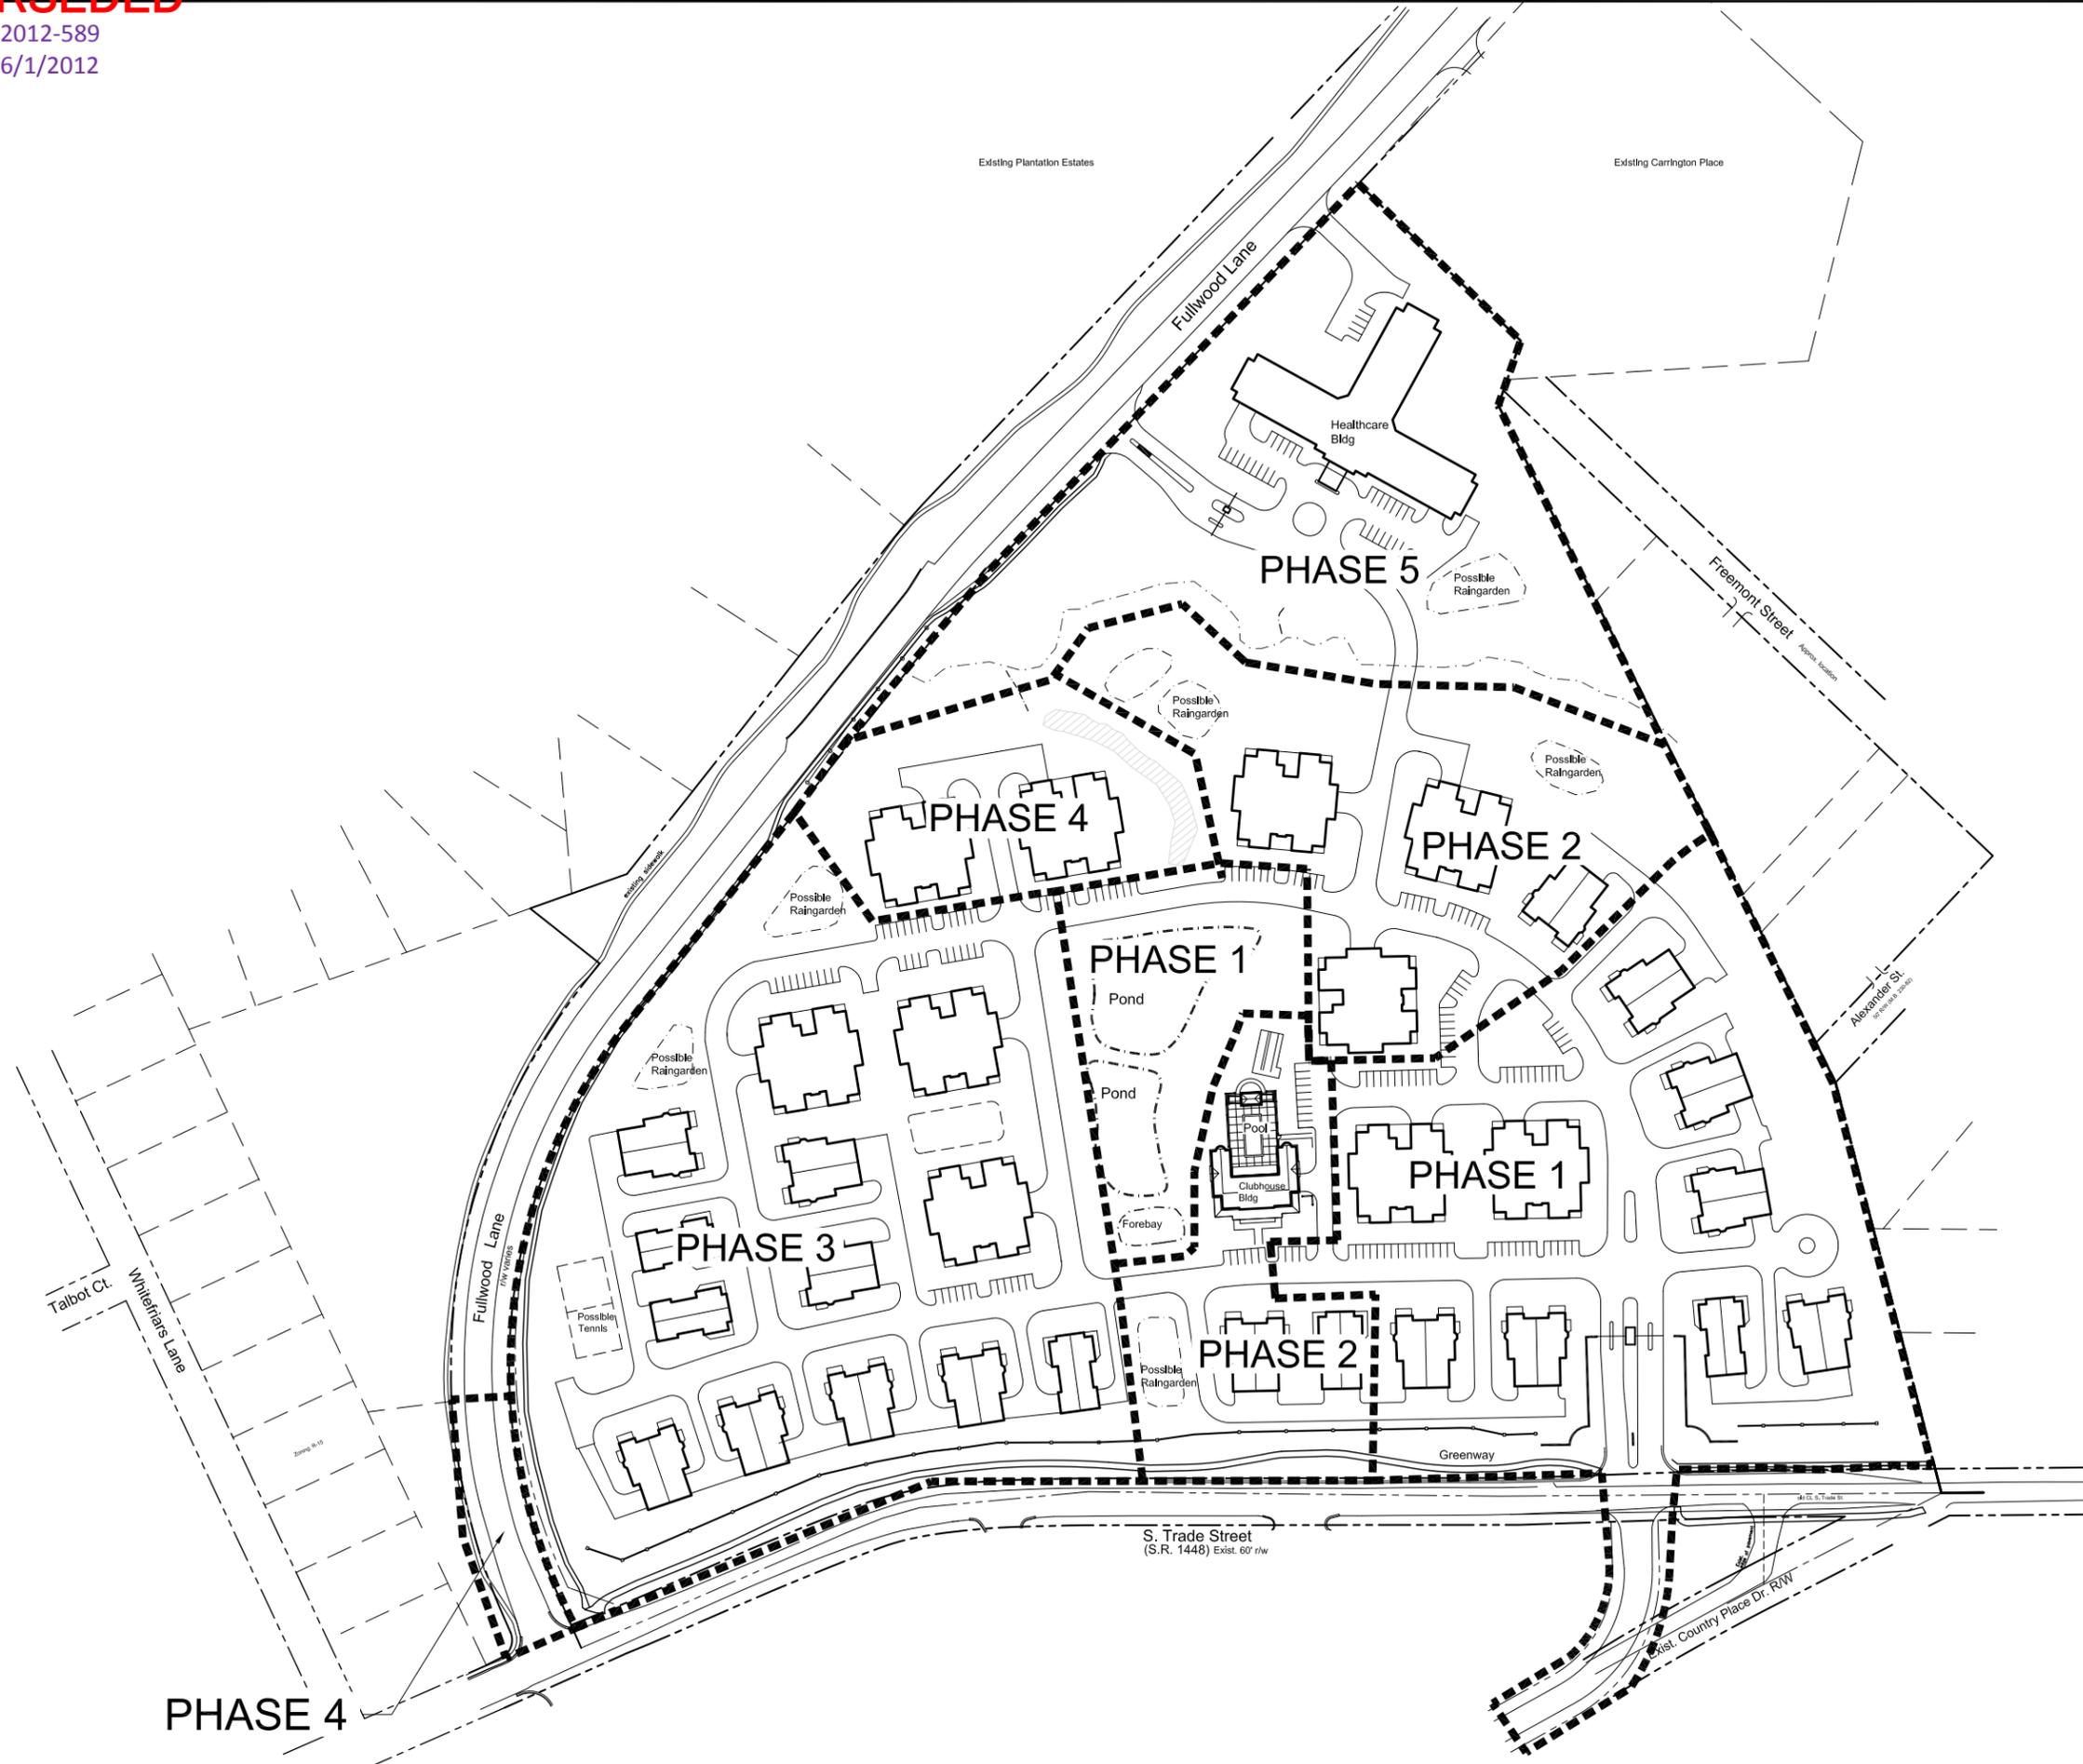

NOTES:

1. THE PHASING SHOWN ON THIS PLAN IS CONCEPTUAL, AND IS SUBJECT TO MODIFICATION BASED ON MARKET CONDITIONS, THE 'DEVELOPMENT STANDARDS', AND OTHER SITE CONDITIONS.

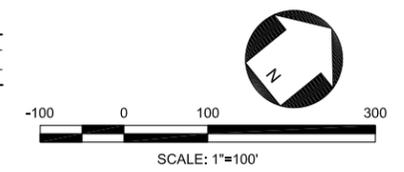

REVISIONS:

No.	Date	By

P:\2011 Jobs\11015 - Village at Plantation Estates\CAD\11015 Base.dwg

SUPERSEDED

2012-589
6/1/2012



Landworks
Design Group, P.A.
P.O. Box 78060
Charlotte, NC 28271
704-841-1604 fax: 704-841-1604



FreemanWhite



**THE VILLAGE AT
PLANTATION ESTATES**
MATTHEWS, NC
REZONING PETITION # _____

**TREE SAVE
PLAN**

Project Manager: MDL

Drawn By: MDL/TMM

Checked By:

Date: 5/31/12

Project Number: 11015

Sheet Number:

ZP-05



Notes:
1. Tree protection/mitigation zones shown on this plan are conceptual, and are subject to adjustment during the construction document phase, as required to meet zoning ordinance requirements.

LEGEND

	existing deciduous tree
	existing coniferous tree
	tree protection zone
	tree save/mitigation zone




SCALE: 1"=100'


REVISIONS:

No.	Date	By

P:\2011 Jobs\11015 - Village at Plantation Estates\CAD\11015 Base.dwg

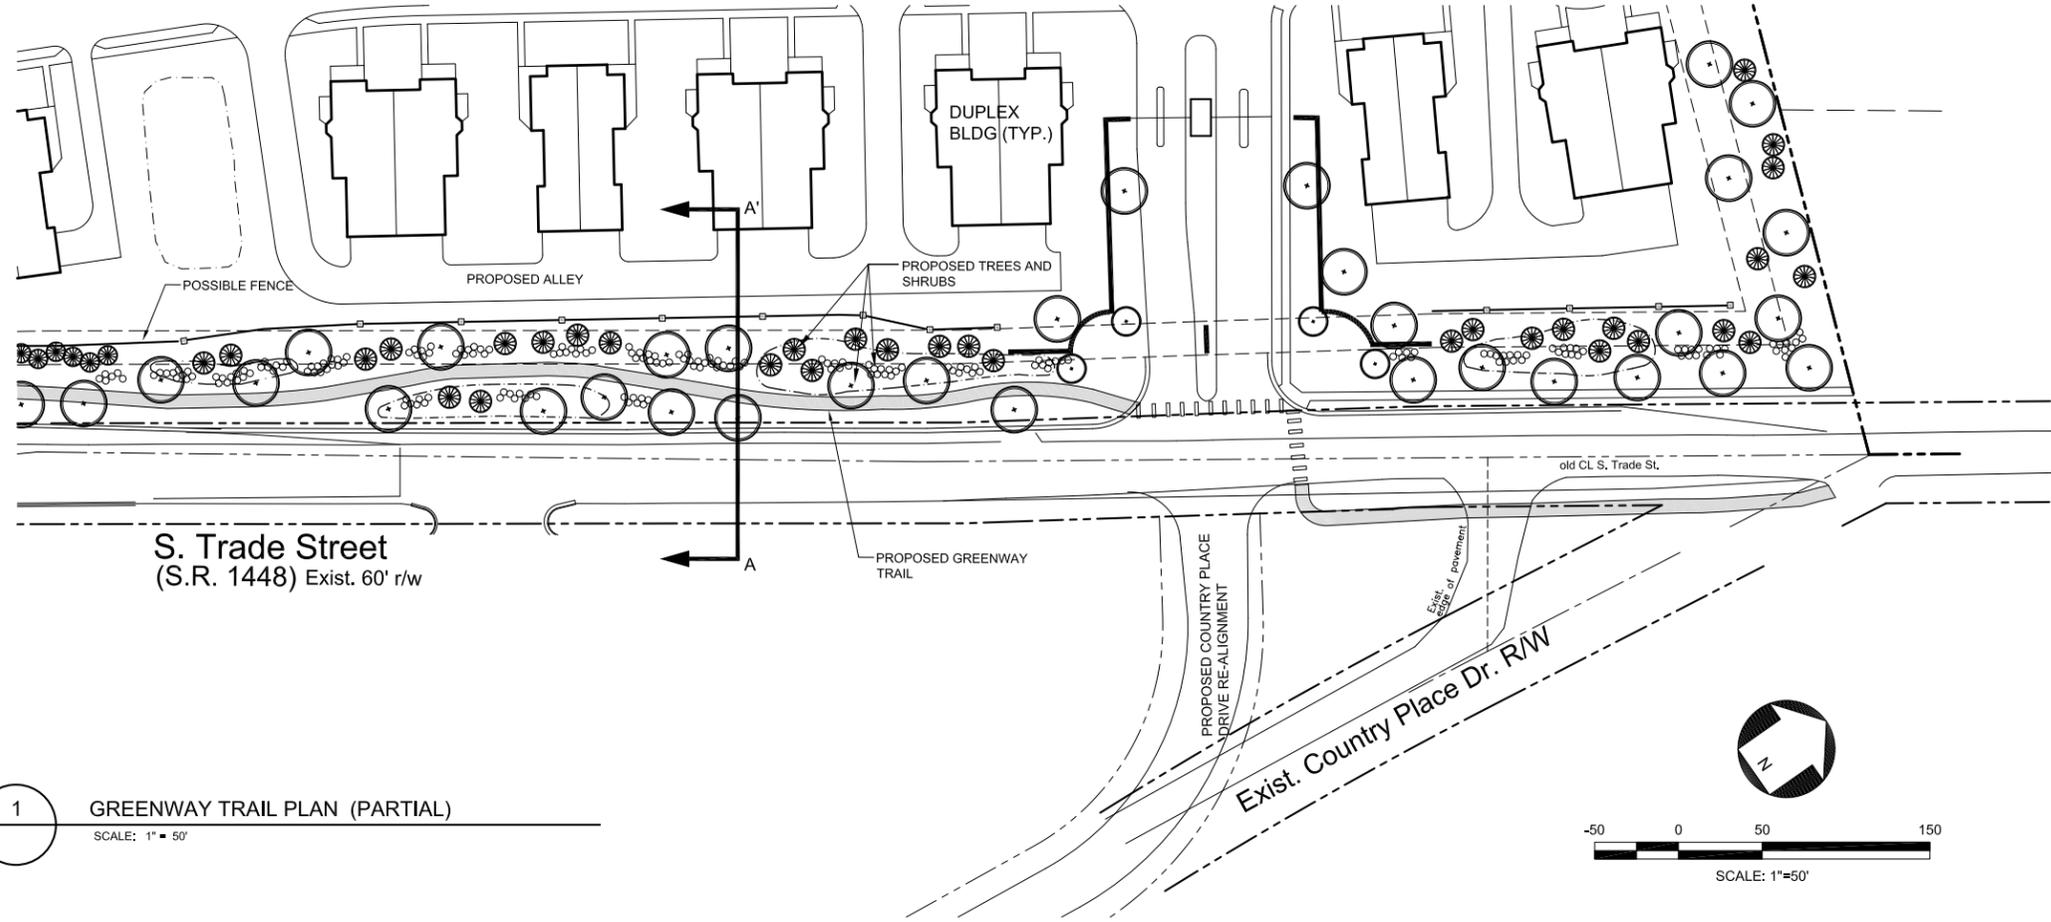

1 GREENWAY TRAIL PLAN (PARTIAL)
SCALE: 1" = 50'

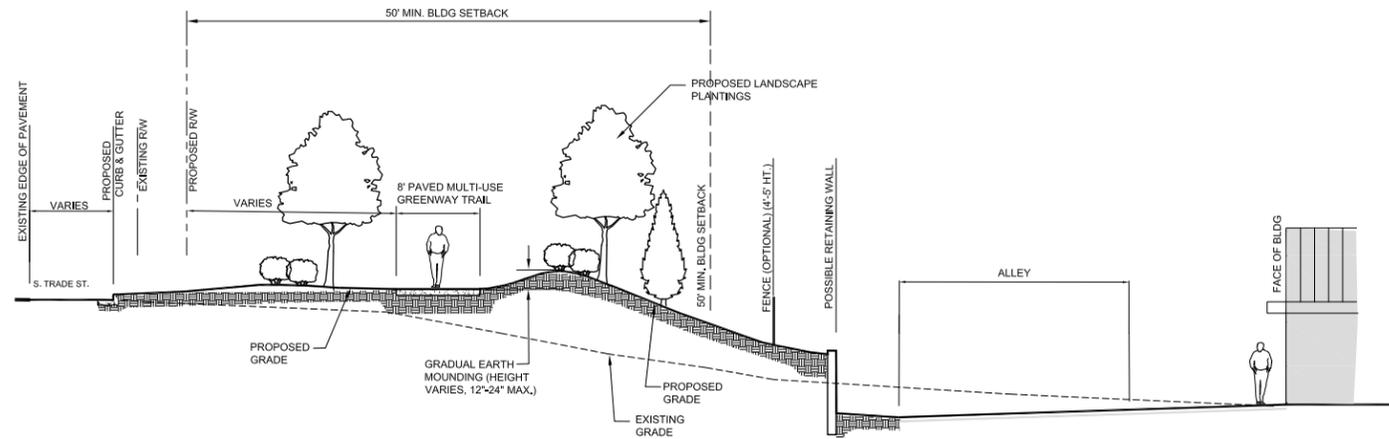

2 SECTION A - A' AT S. TRADE STREET
SCALE: 1/8" = 1'-0"

Landworks
Design Group, P.A.
P.O. Box 78060
Charlotte, NC 28271
704-841-1604 fax: 704-841-1604

Single Source
DESIGN BUILD

FreemanWhite

ACTS
Retirement-Life Communities*

THE VILLAGE AT
PLANTATION ESTATES
MATTHEWS, NC
REZONING PETITION #

GREENWAY TRAIL DETAILS


Project Manager: MDL
Drawn By: MDL, TMM
Checked By:
Date: 5/31/12
Project Number: 11015

REVISIONS:


No.	Date	By

Sheet Number:
ZP-06


2012-589
6/1/2012

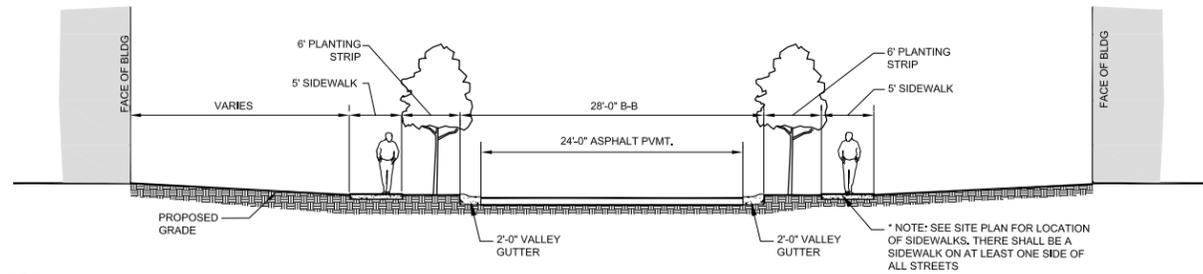


1 TYPICAL INTERNAL STREET TYPE 'A' (PRIVATE)
SCALE: 1/8" = 1'-0"

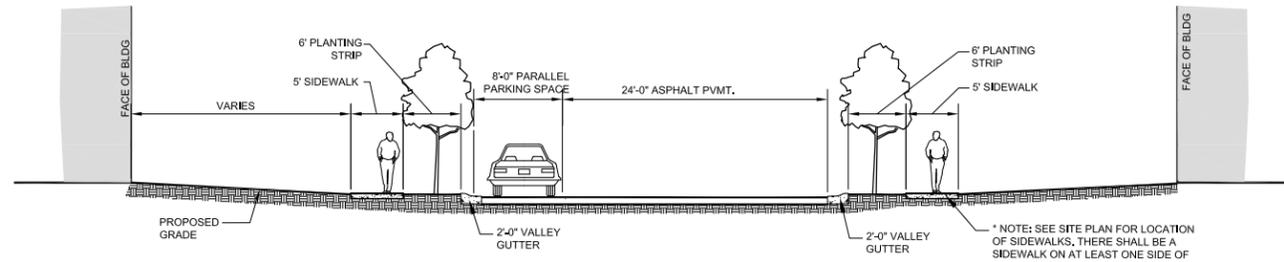

2 TYPICAL INTERNAL STREET TYPE 'A' WITH PARALLEL PARKING
SCALE: 1/8" = 1'-0"

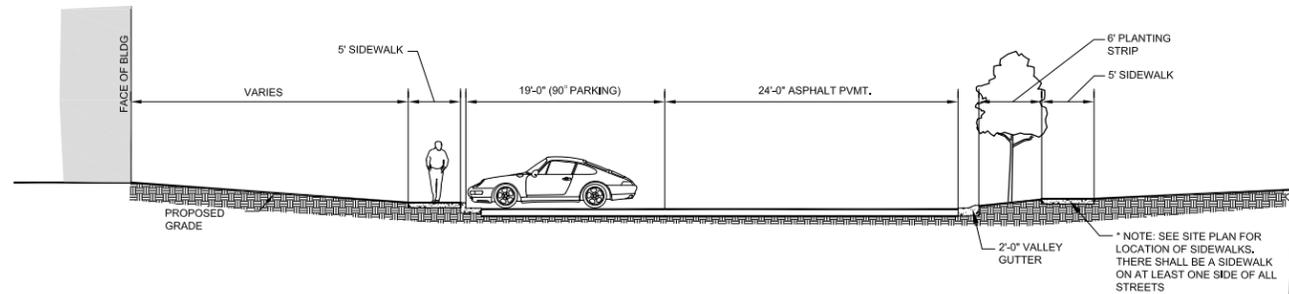

3 TYPICAL INTERNAL STREET TYPE 'A' WITH ANGLED PARKING (PRIVATE)
SCALE: 1/8" = 1'-0"

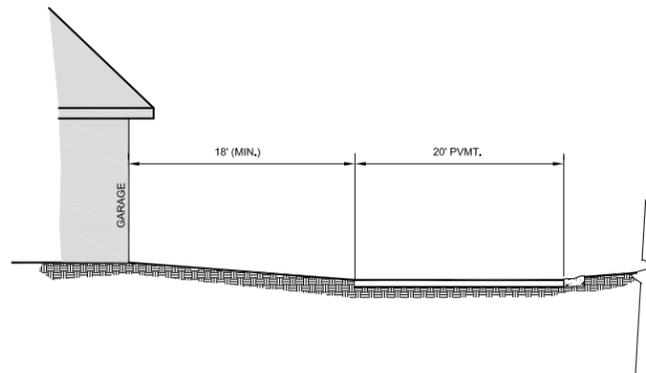

4 TYPICAL ALLEY (SERVING 5 OR MORE DUPLEX UNITS)
SCALE: 1/8" = 1'-0"



Landworks
Design Group, P.A.
P.O. Box 78060
Charlotte, NC 28271
704-841-1604 fax: 704-841-1604



FreemanWhite



**THE VILLAGE AT
PLANTATION ESTATES**
MATTHEWS, NC
REZONING PETITION # _____

DETAILS

Project Manager: MDL
Drawn By: AMC
Checked By: TMM
Date: 5/31/12
Project Number: 11015

Sheet Number:

ZP-07

REVISIONS:

No.	Date	By

SUPERSEDED

2012-589
6/1/2012



1850 DUPLEX (STREET ELEVATION)
SCALE: 1/8" = 1'-0"



1850 DUPLEX (REAR ELEVATION) - SIDE ENTRY GARAGE OPTION
SCALE: 1/8" = 1'-0"



1850 DUPLEX (REAR ELEVATION) - FRONT ENTRY GARAGE OPTION
SCALE: 1/8" = 1'-0"



2050 DUPLEX (STREET ELEVATION)
SCALE: 1/8" = 1'-0"



2050 DUPLEX (REAR ELEVATION) - SIDE ENTRY GARAGE OPTION
SCALE: 1/8" = 1'-0"



2050 DUPLEX (REAR ELEVATION) - FRONT ENTRY GARAGE OPTION
SCALE: 1/8" = 1'-0"



CLUBHOUSE (POND SIDE ELEVATION)
SCALE: 1/8" = 1'-0"



CLUBHOUSE (STREET ELEVATION)
SCALE: 1/8" = 1'-0"

DRAWINGS ARE CONCEPTUAL AND ARE SUBJECT TO CHANGE



Landworks
Design Group, P.A.
P.O. Box 78060
Charlotte, NC 28271
704-841-1604 fax: 704-841-1604



FreemanWhite

ACTS
Retirement-Life
Communities®

THE VILLAGE AT
PLANTATION ESTATES
MATTHEWS, NC
REZONING PETITION # _____

BUILDING
ELEVATIONS

Project Manager: spc

Drawn By: spc

Checked By: spc

Date: 5/31/12

Project Number: 11015

Sheet Number:

ZP-08

REVISIONS:

No.	Date	By

SUPERSEDED

2012-589
6/1/2012



MAISON COURT APARTMENT BUILDING (REAR ELEVATION)
SCALE: 1/8" = 1'-0"



MAISON COURT APARTMENT BUILDING (STREET ELEVATION)
SCALE: 1/8" = 1'-0"



HEALTHCARE BUILDING (FRONT ELEVATION)
SCALE: 3/32" = 1'-0"

P:_Steve CV\illage at Plantation Estates\02 PREDESIGN FILES\04 Master Planning - Studies\02 CAD Files\LW TITLE BLOCK 5-23-12.dwg



Landworks
Design Group, P.A.
P.O. Box 78060
Charlotte, NC 28271
704-841-1604 fax: 704-841-1604



FreemanWhite



THE VILLAGE AT
PLANTATION ESTATES
MATTHEWS, NC
REZONING PETITION # _____

**BUILDING
ELEVATIONS**

Project Manager: spc

Drawn By: spc

Checked By: spc

Date: 5/31/12

Project Number: 11015

Sheet Number:

ZP-09

DRAWINGS ARE CONCEPTUAL AND ARE SUBJECT TO CHANGE

No.	Date	By